FROM THE OFFICE OF

Certificate of Survey

CHARLES O. GEORGI COMPANY

2215 West County Road B

Saint Paul, Minnesota 55113

REGISTERED CIVIL ENGINEER AND LAND SURVEYOR

I Hereby Certify that this plat shows a survey made by me of the property described on this plat, and that the corners are correctly placed as shown, and that all locations have been correctly shown.

Surveyed For Hiner Const.


Date October 1974

Scale |" = 40'

Sharles O. Leongi RECUSTERED LAND SURVEYOR

Description:

Lot S, Block G, Lake Veiw Hills No.3 Ramsey County, Minnesota.

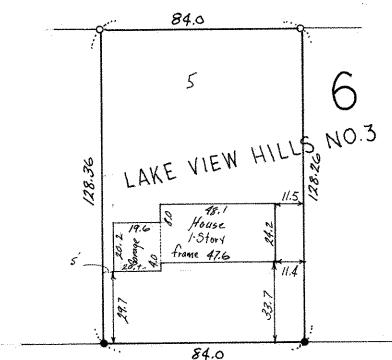

o denotes iron pipe monuments

denotes iron pipe monuments
found in place

ELM DRIVE