FROM THE OFFICE OF

## Certificate is a survey is

## CHARLES O. GEORGI COMPANY

2215 West County Road B

Saint Paul, Minnesota 55113

REGISTERED CIVIL ENGINEER AND LAND SURVEYOR

I Hereby Certify that this plat shows a survey made by me of the property described on this plat, and that the corners are correctly placed as shown, and that all locations have been correctly shown.

Surveyed For Met HINEL

Date December 1365


By Marke . Lorge REGISTERED LAND SURVEYOR

Description:

Lot 7 Block 1

LAKE VIEW TERRACE

MOSBY

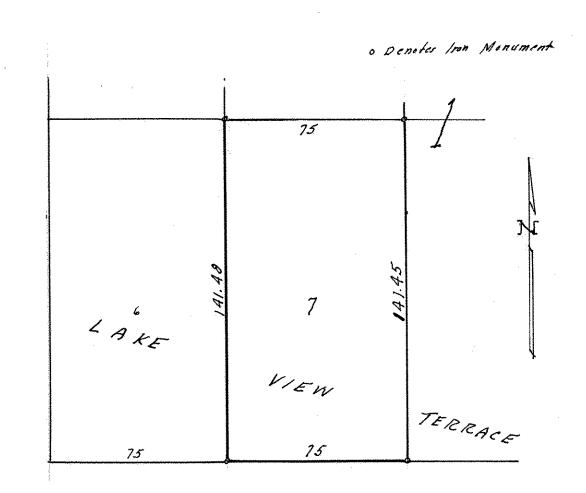

JANSEN : AVE.