SE 15 30 22

Certificate of Survey

From the office of

GEORGI- SCHMIDT & ASSOC. INC.

3092 No. Lexington Ave., Roseville, Mn. 55113
LAND SURVEYING
483-4408

I Hereby Certify that this plat shows a survey made by me of the property described on this plat, and that the corners are correctly placed as shown, and that all locations have been correctly shown.
11/15/79 Set Additional irons on South Line 4th St. DWS

Job Number: 534

Surveyed For Kim Perkins

Date 11/9/79

Scale 1" = 60'

By Donald W. Schmidt
REGISTERED LAND SURVEYOR

Description: (New)

That part of the North 497.51 feet of the NE¼ of the NE¼ of the SE¼ of Section 15,T30N,R22W, lying southerly of the southerly line of Fourth Street, subject to Dillon Street over the East 33 feet thereof.
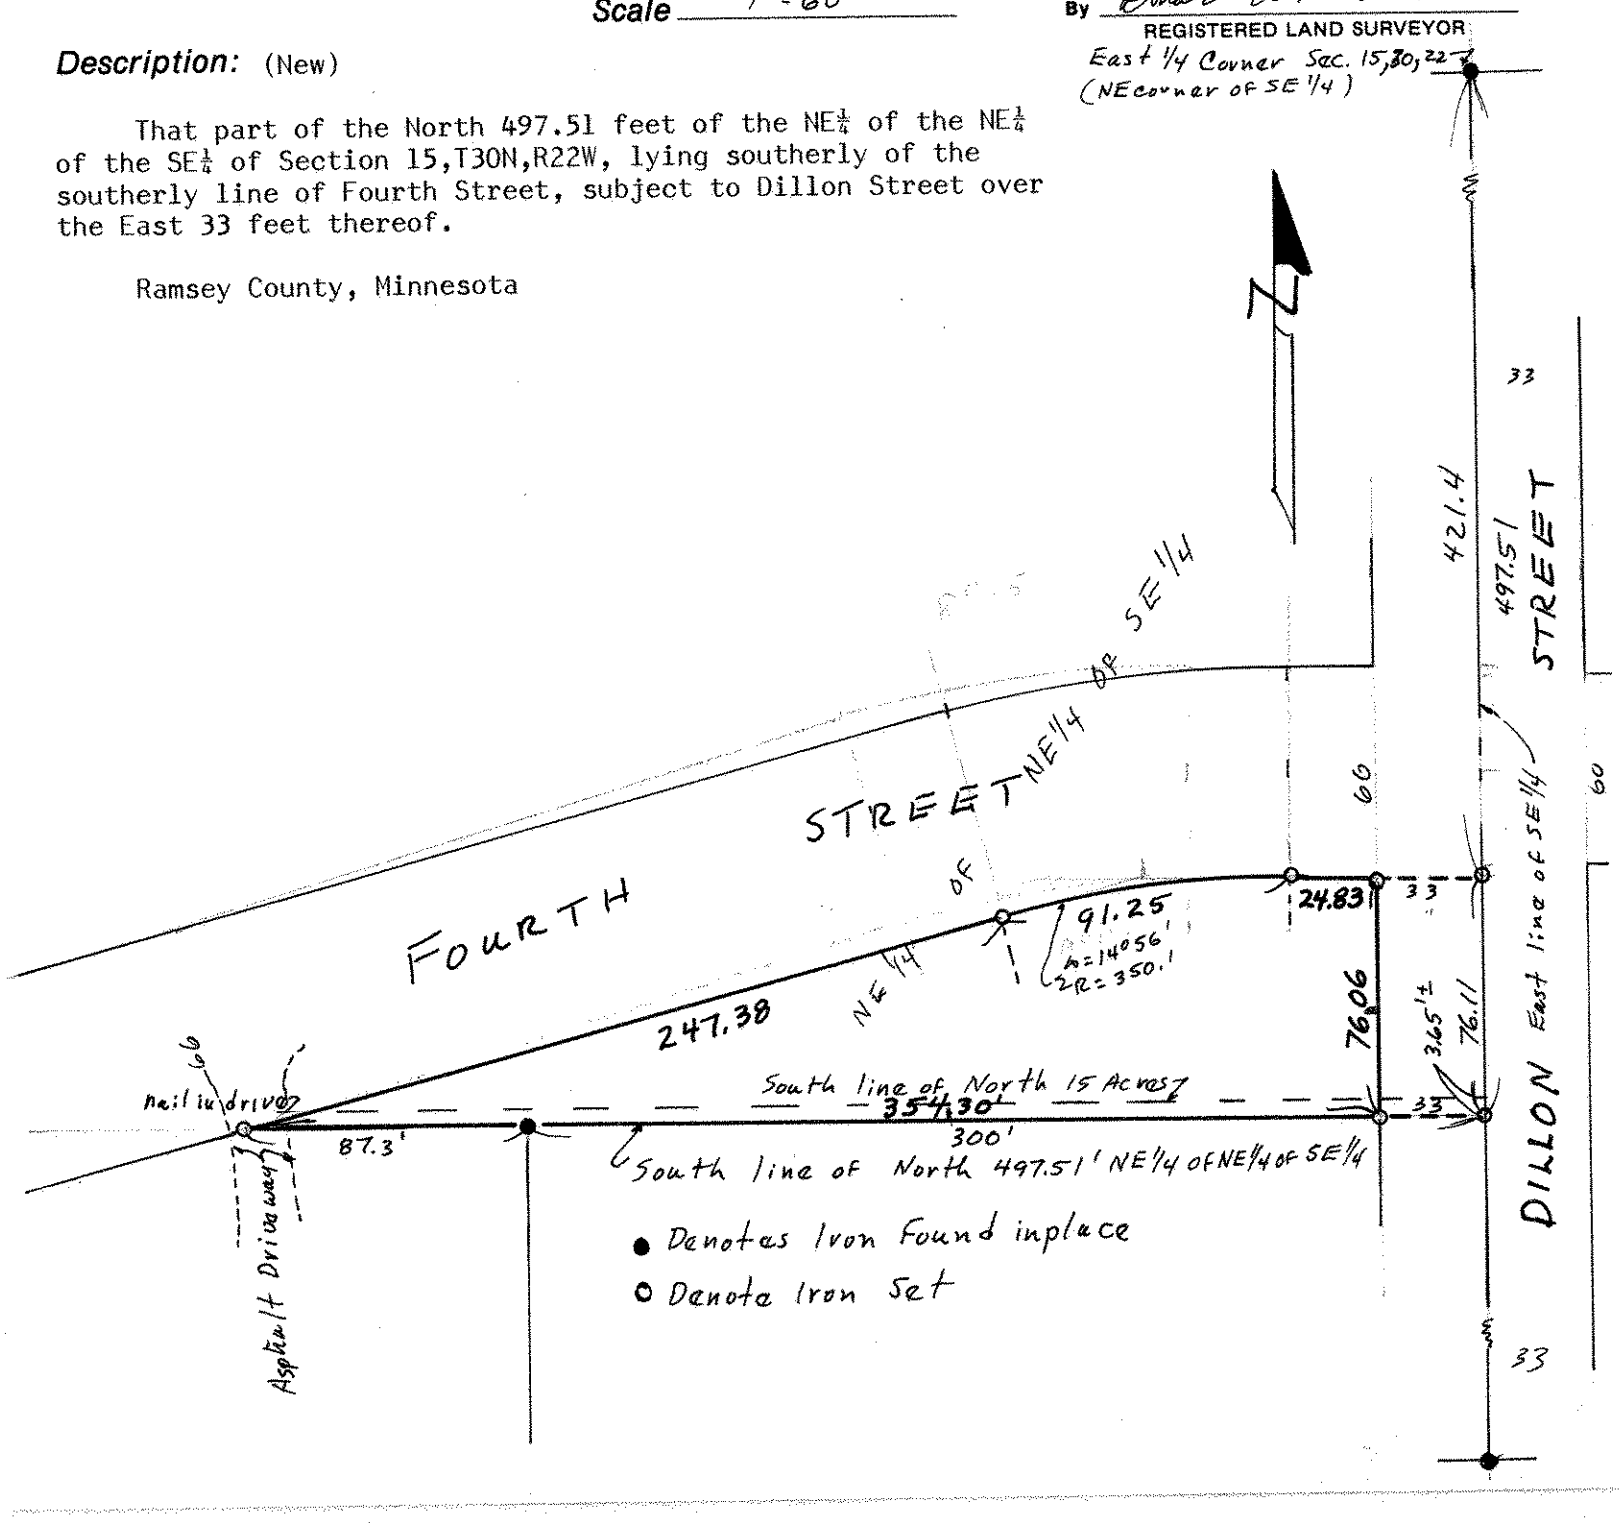
Ramsey County, Minnesota