NW 26 3022

FROM THE OFFICE OF

CHARLES O. GEORGI COMPANY

2215 West County Road B Saint Paul, Minnesota 55113

REGISTERED CIVIL ENGINEER AND LAND SURVEYOR

Certificate of Survey

I Hereby Certify that this plat shows a survey made by me of the property described on this plat, and that the corners are correctly placed as shown, and that all locations have been correctly shown.

Surveyed For Jeffery Proud

Date July 1971

Scale 1" = 100

By Charles O. Georgi
REGISTERED LAND SURVEYOR

Description:

Lot 13, Block 6, Rearrangement of White Bear Park, Ramsey County, Minn.
except the North 88 feet thereof,
except the South 96 feet of the East 120 feet thereof; and
except the East 10 feet thereof for widening White Bear Ave.
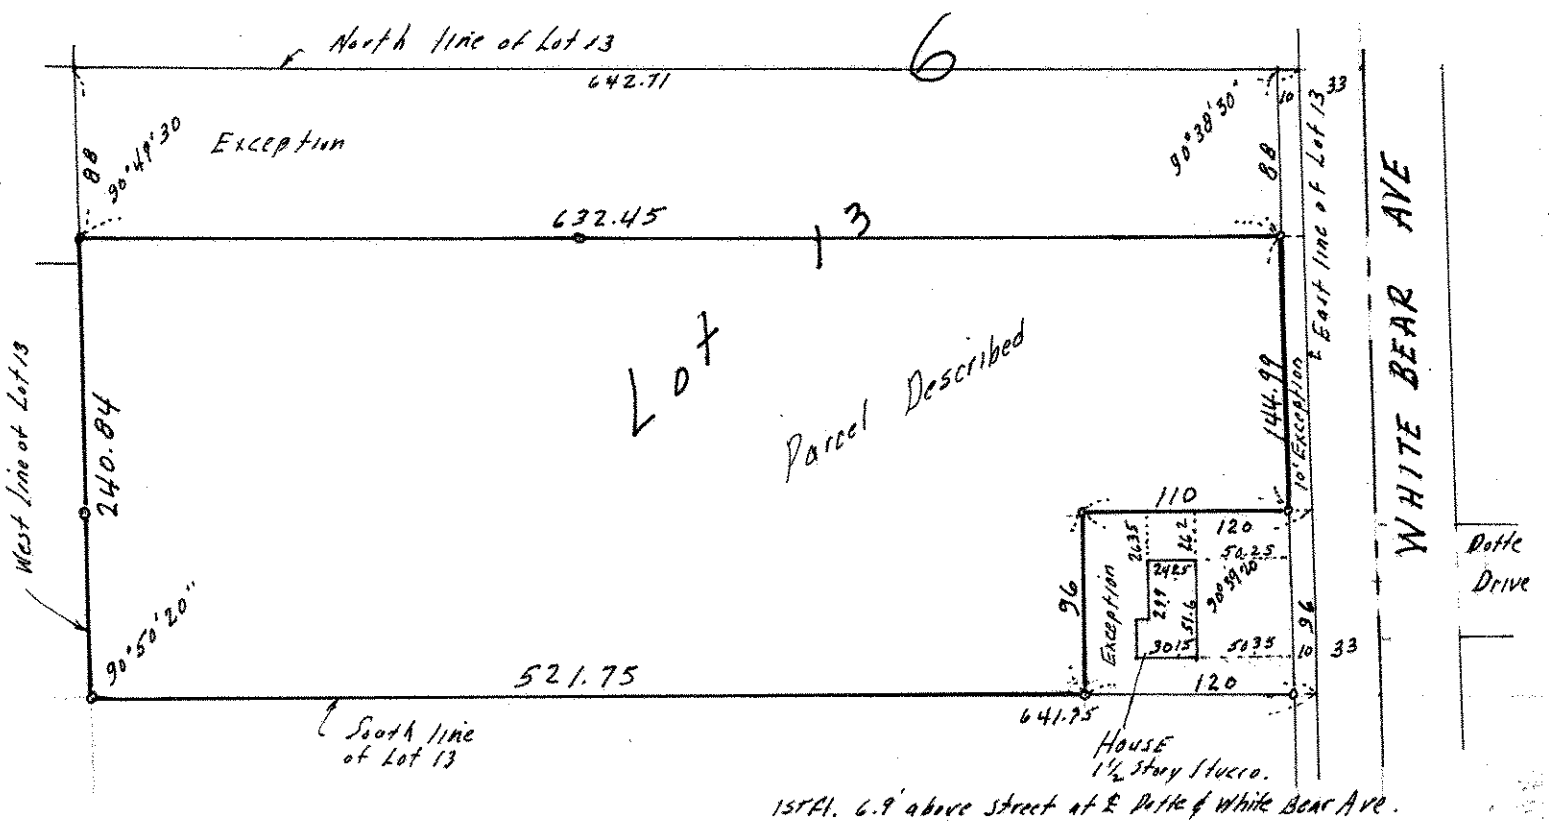
o Denotes Iron Monument.