NW 14 30 22

Certificate of Survey

From the office of

GEORGI- SCHMIDT & ASSOC. INC.

3092 No. Lexington Ave., Roseville, Mn. 55113

LAND SURVEYING

483-4408

I Hereby Certify that this plat shows a survey made by me of the property described on this plat, and that the corners are correctly placed as shown, and that all locations have been correctly shown.

Job Number: 129

Surveyed For Pratt Const.

Date September 1978

Scale 1" = 40'

By Donald W Schmidt

REGISTERED LAND SURVEYOR

Description:

Lot 7, Block 3

Garden Lane Addition
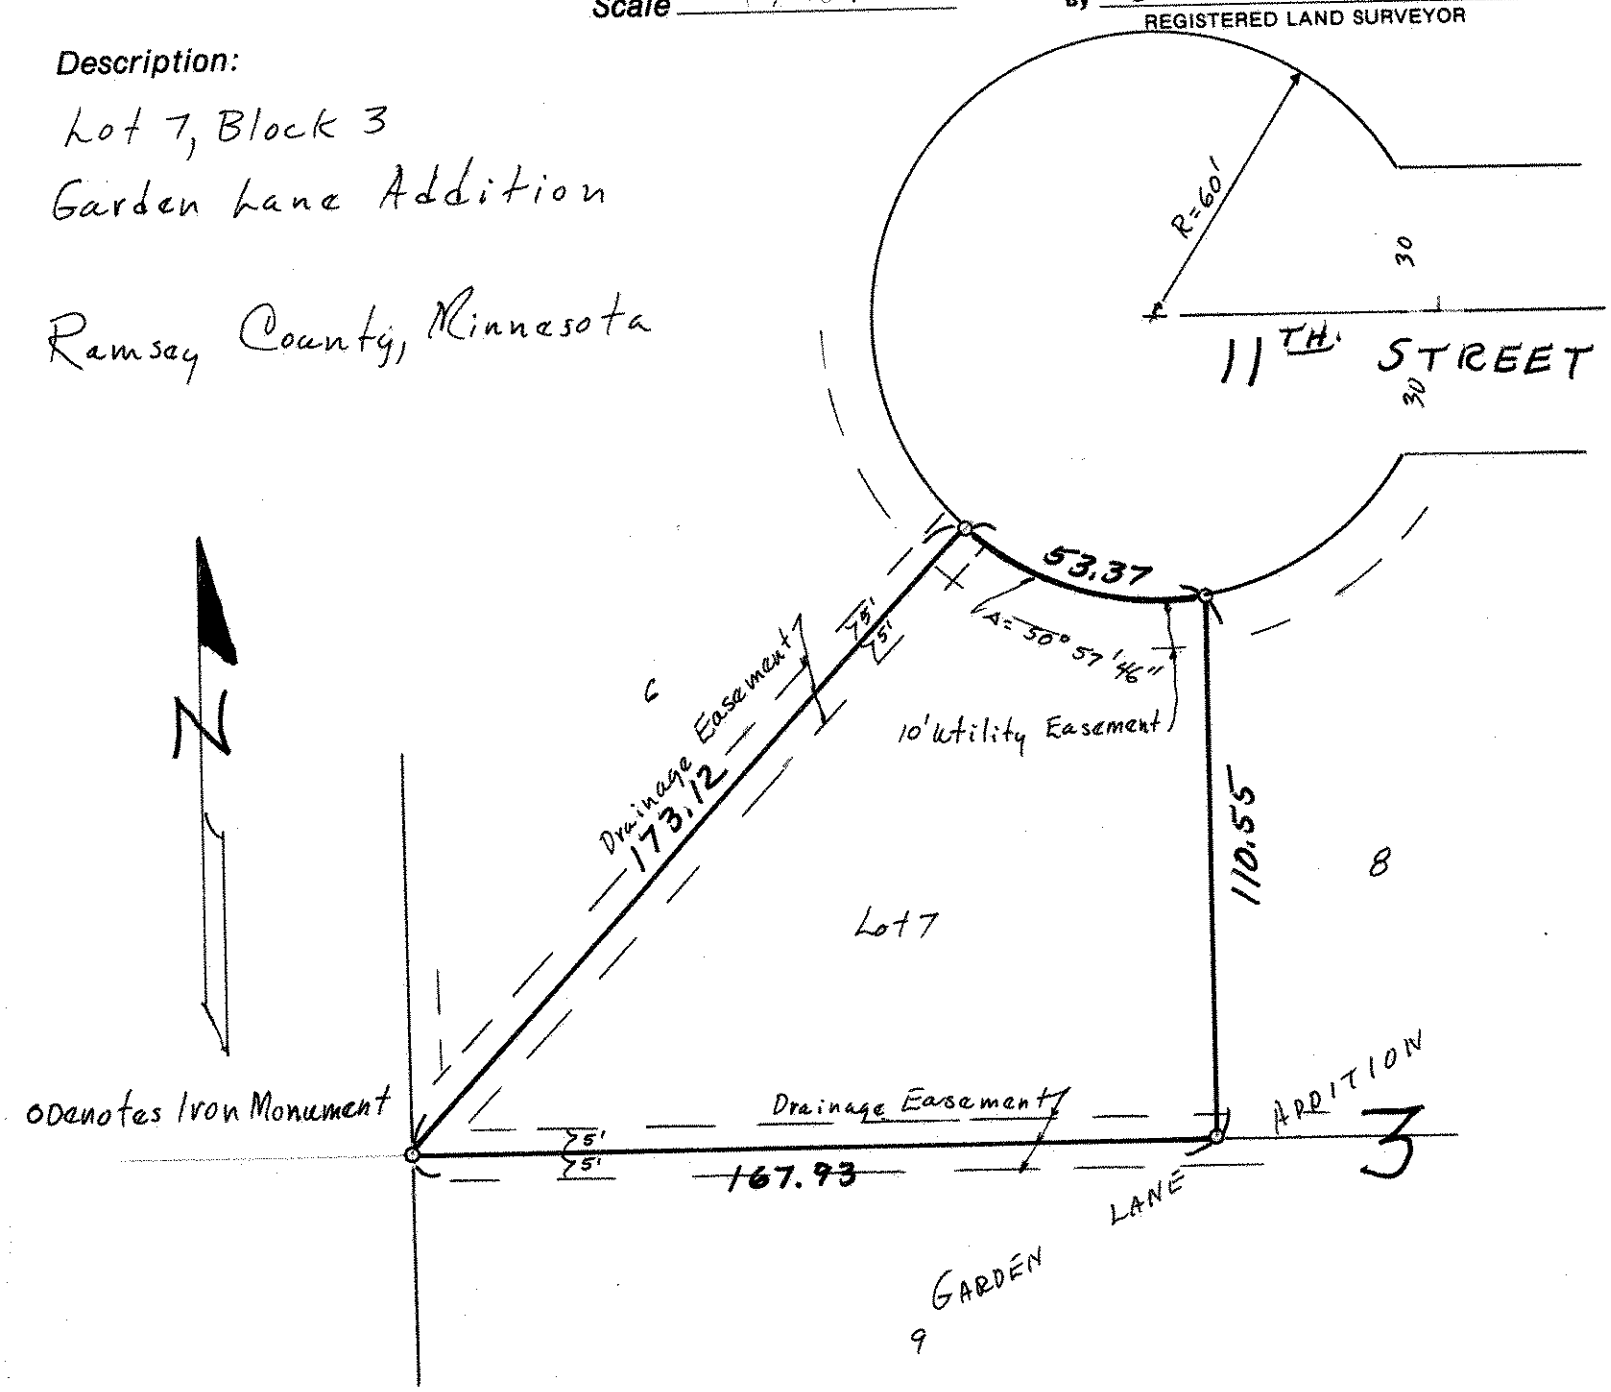
Ramsey County, Minnesota