

14 30 22

FROM THE OFFICE OF

# CHARLES O. GEORGI COMPANY

2215 West County Road B

Saint Paul 13, Minnesota

REGISTERED CIVIL ENGINEER AND LAND SURVEYOR

## Certificate of Survey




I Hereby Certify that this plat shows a survey made by me of the property described on this plat, and that the corners are correctly placed as shown, and that all locations have been correctly shown.

Surveyed For Mr. L. Pearlman  
Date May 1959  
Scale 1" = 40'

By Charles O. Georgi  
REGISTERED LAND SURVEYOR

Description:

The South 50 feet of Lot 6  
Block 63  
White Bear  
White Bear, Minn.

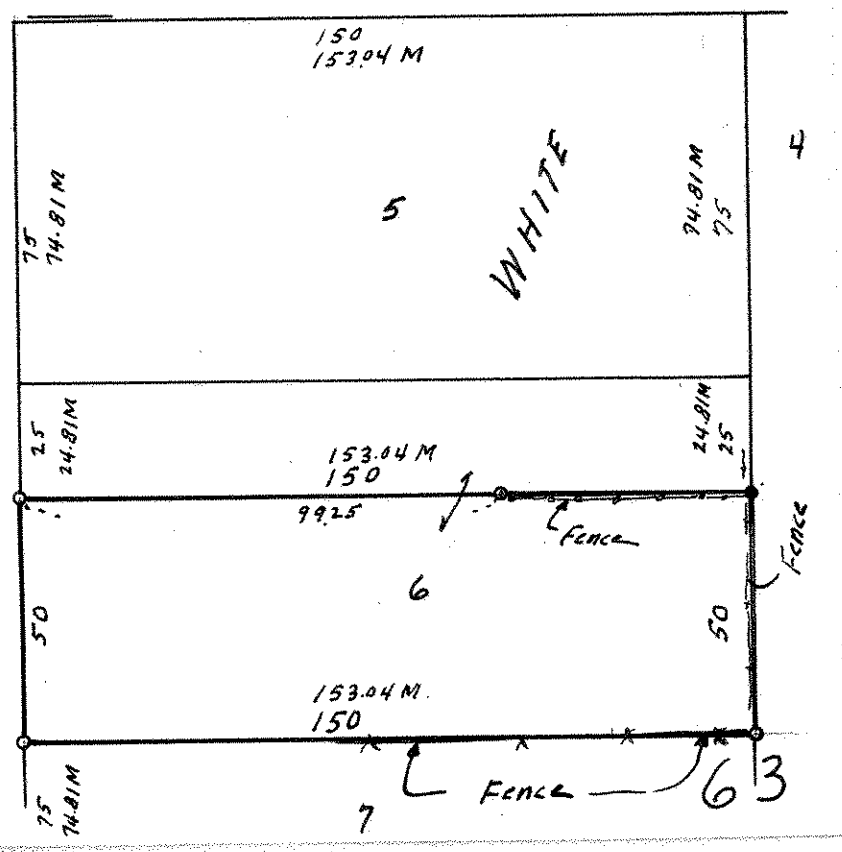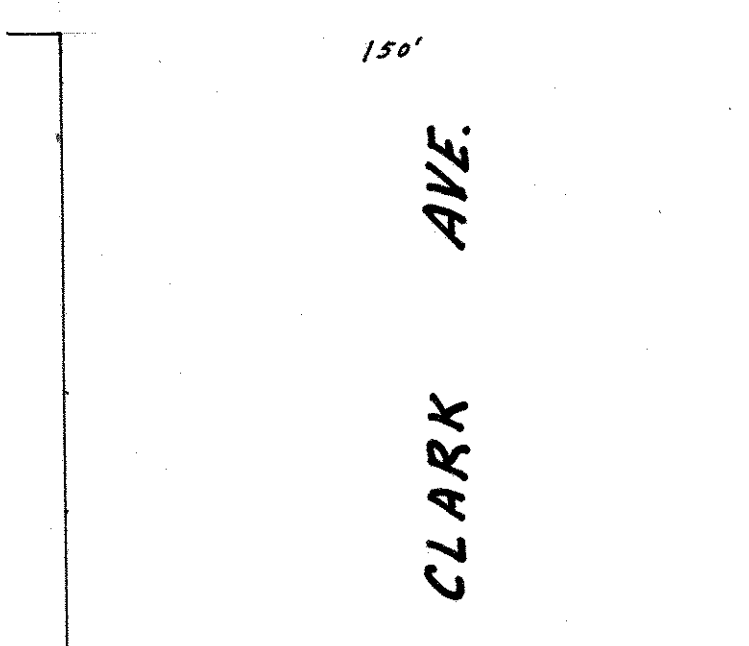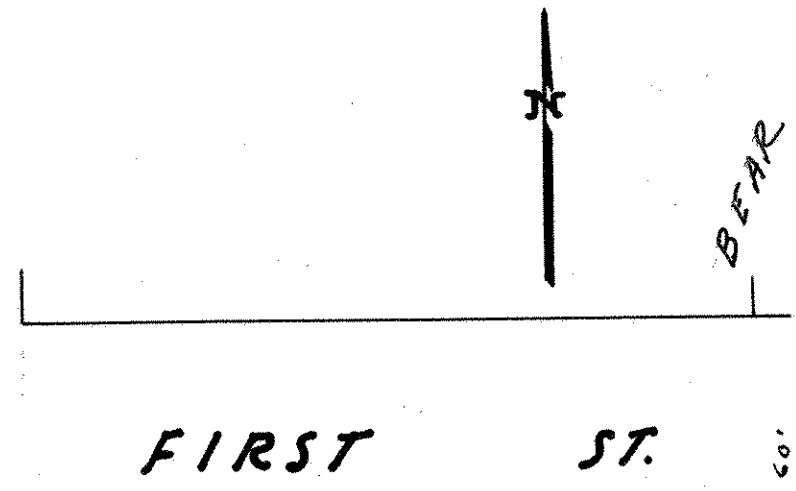

o Denotes Iron Monument  
M - Denotes Prorated measure  
for Block Excess or shortage.