

SE 14 30 22

# Certificate of Survey

From the office of  
**GEORGI-SCHMIDT & ASSOC. INC.**  
3092 No. Lexington Ave., Roseville, Mn. 55113  
LAND SURVEYING  
483-4408

I Hereby Certify that this plat shows a survey made by me of the property described on this plat, and that the corners are correctly placed as shown,

Job Number: 1182

Surveyed For Terrence Scherer

Date 6/24/82

Scale 1"=40'

By Ronald W. Schmidt  
REGISTERED LAND SURVEYOR


#10459

### Description:

Lot 3, Block 55, White Bear

Ramsey County, MN

FOURTH ST.

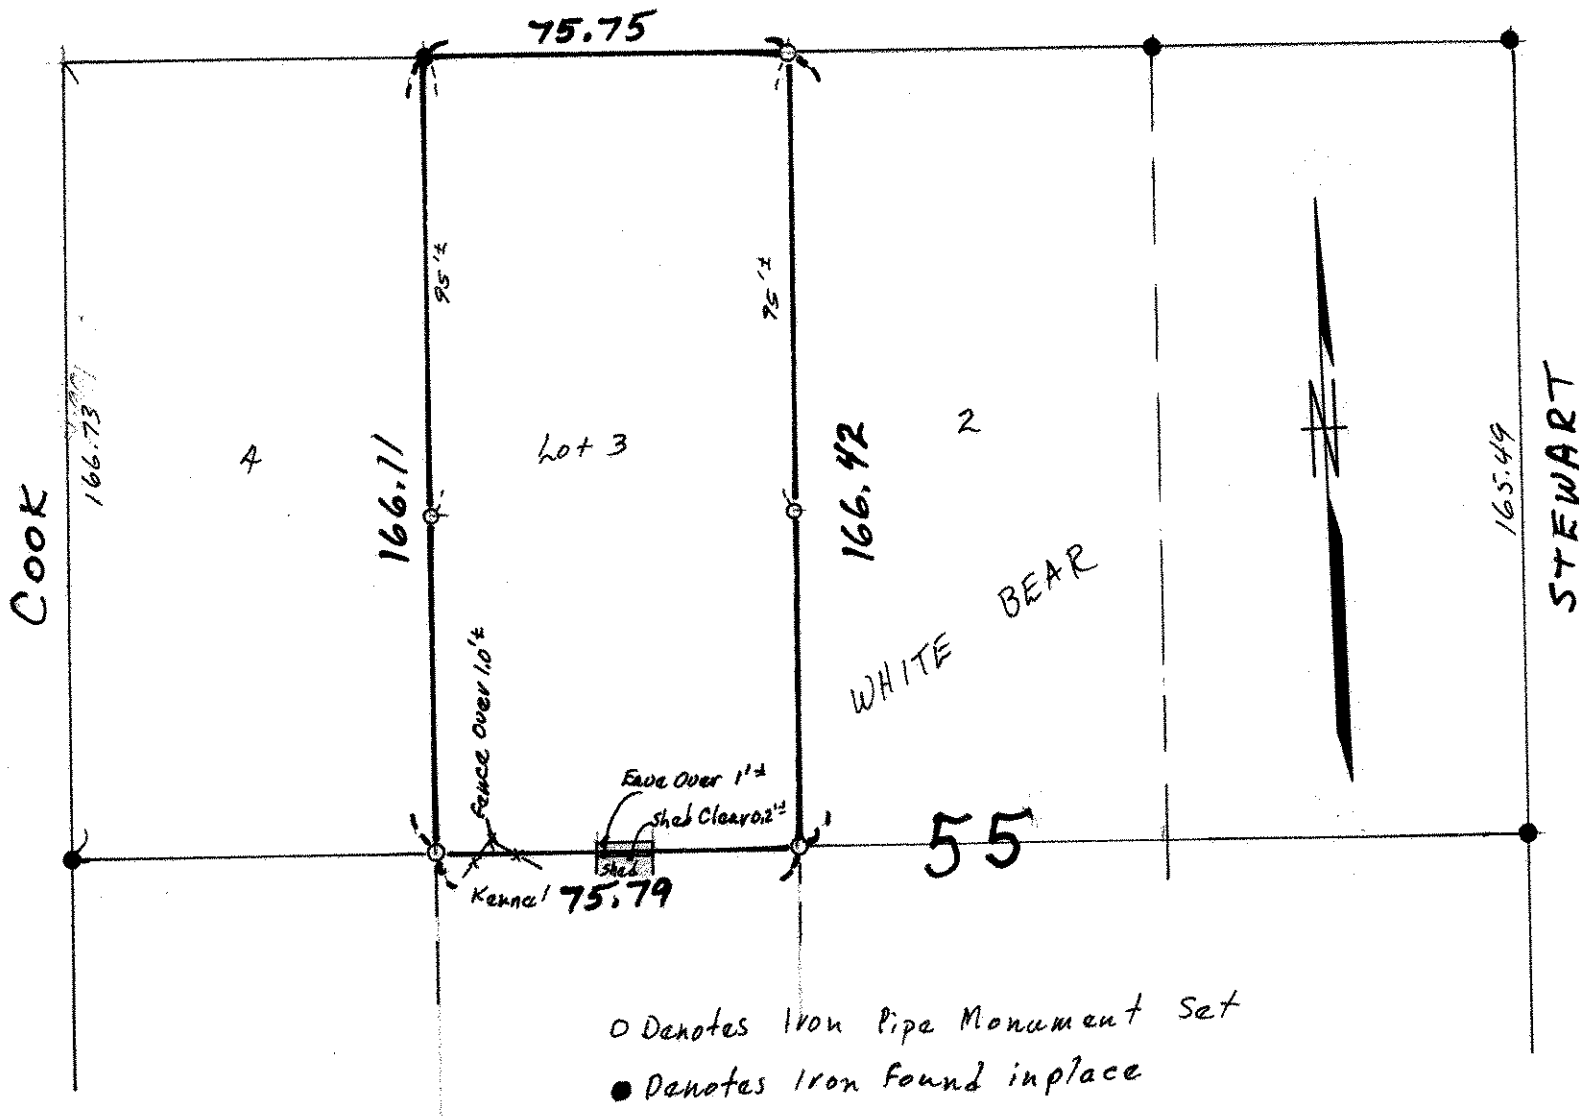

○ Denotes Iron Pipe Monument Set  
● Denotes Iron Found in place