FROM THE OFFICE OF

CHARLES O. GEORGI COMPANY

REGISTERED CIVIL ENGINEER AND LAND SURVEYOR

I Hereby Certify that this plat shows a survey made by me of the property described on this plat, and that the corners are correctly placed as shown, and that all locations have been correctly shown.

Surveyed For Ronald Talmage

Date

Description:


May 1977 11=401 Scale.

Lots 10, and 11, Block 4, Ramaley Park

Ramsey County, Minnesota

Certificate

of Survey

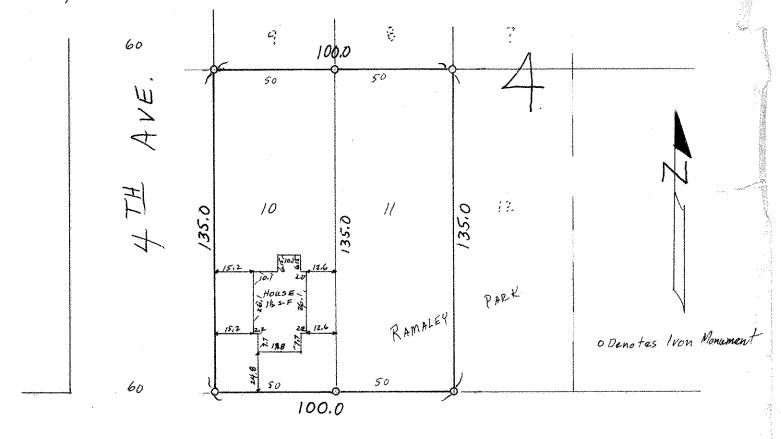

WEBBER ST.