


JOHNSON AVE.

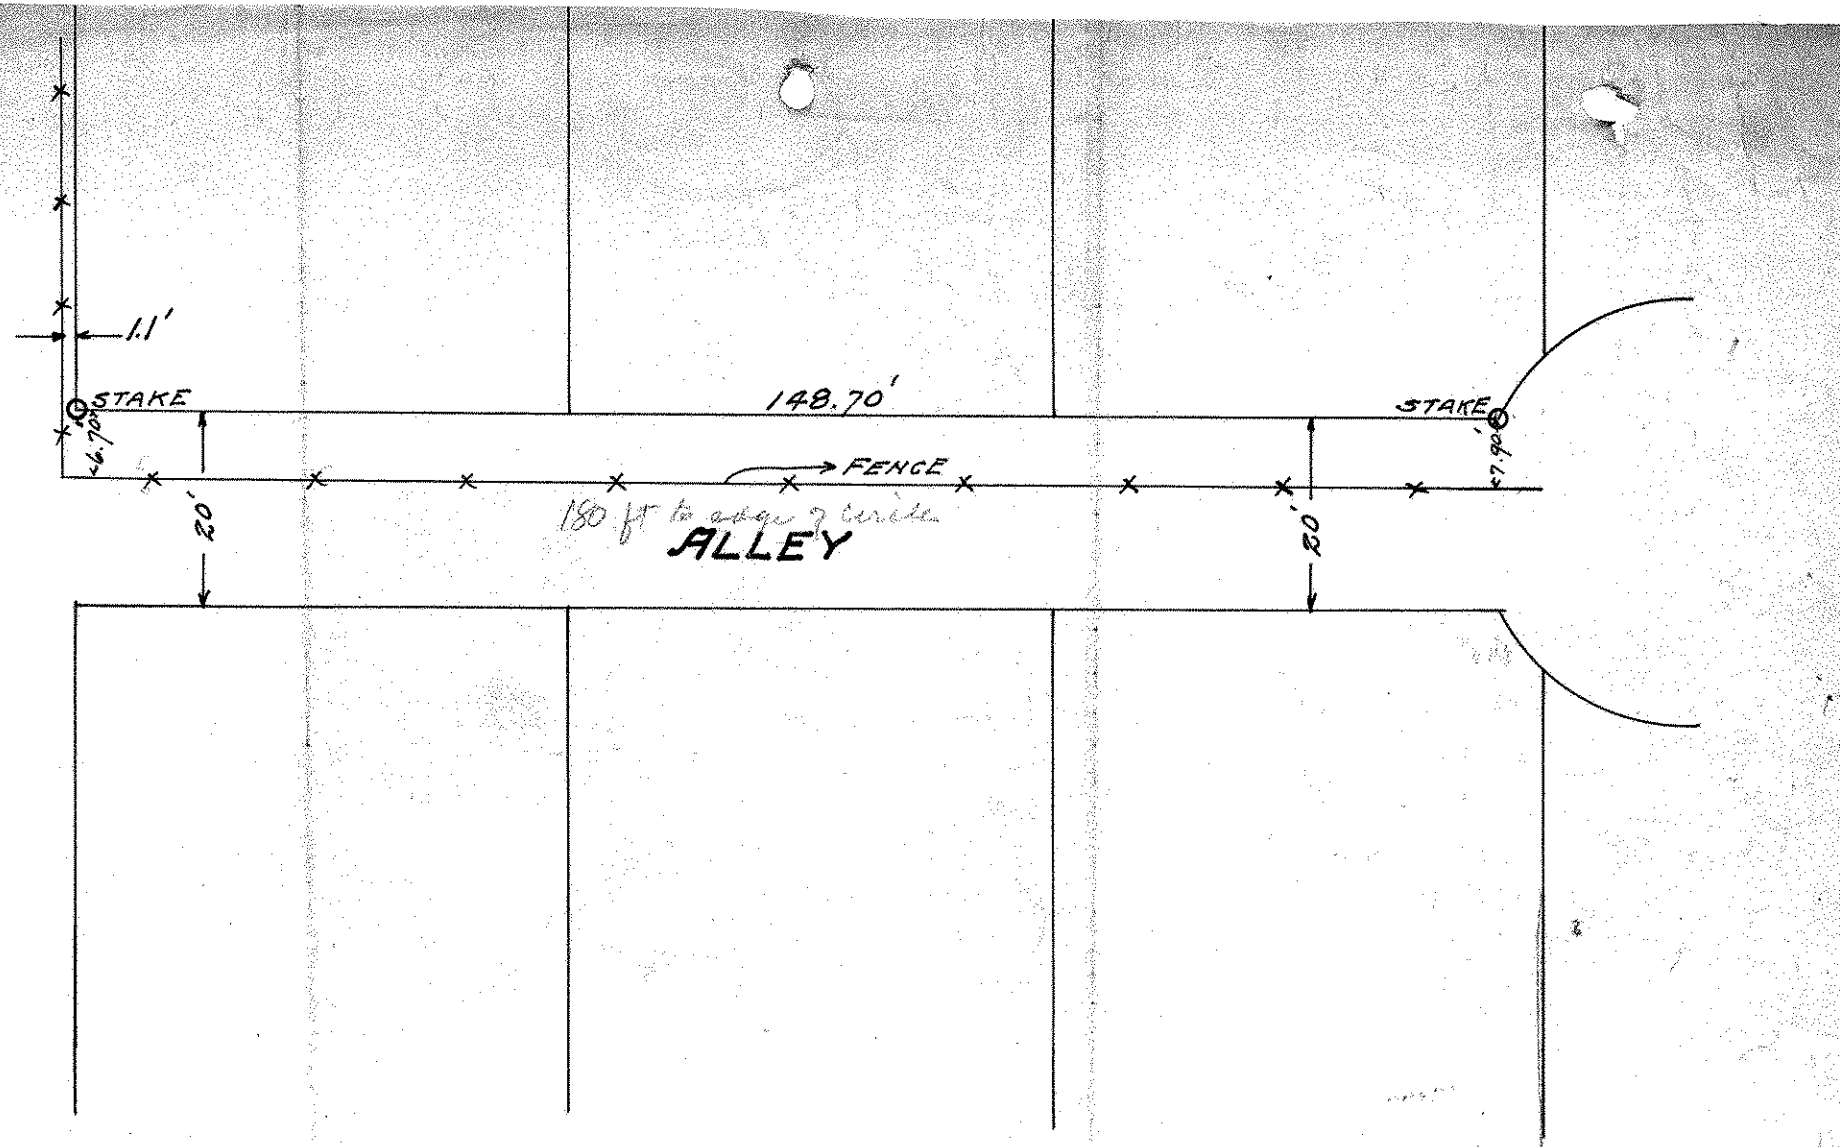

AUG. 2-1921

LOCATION OF FENCE IN BLOCK 19
AUERBACHS RE. OF PART OF WHITE BEAR
SURVEYED FOR VILLAGE OF WHITE BEAR

C. Murray Surveyor.

22-82-13-30-22