


AMERBACHS ZONE

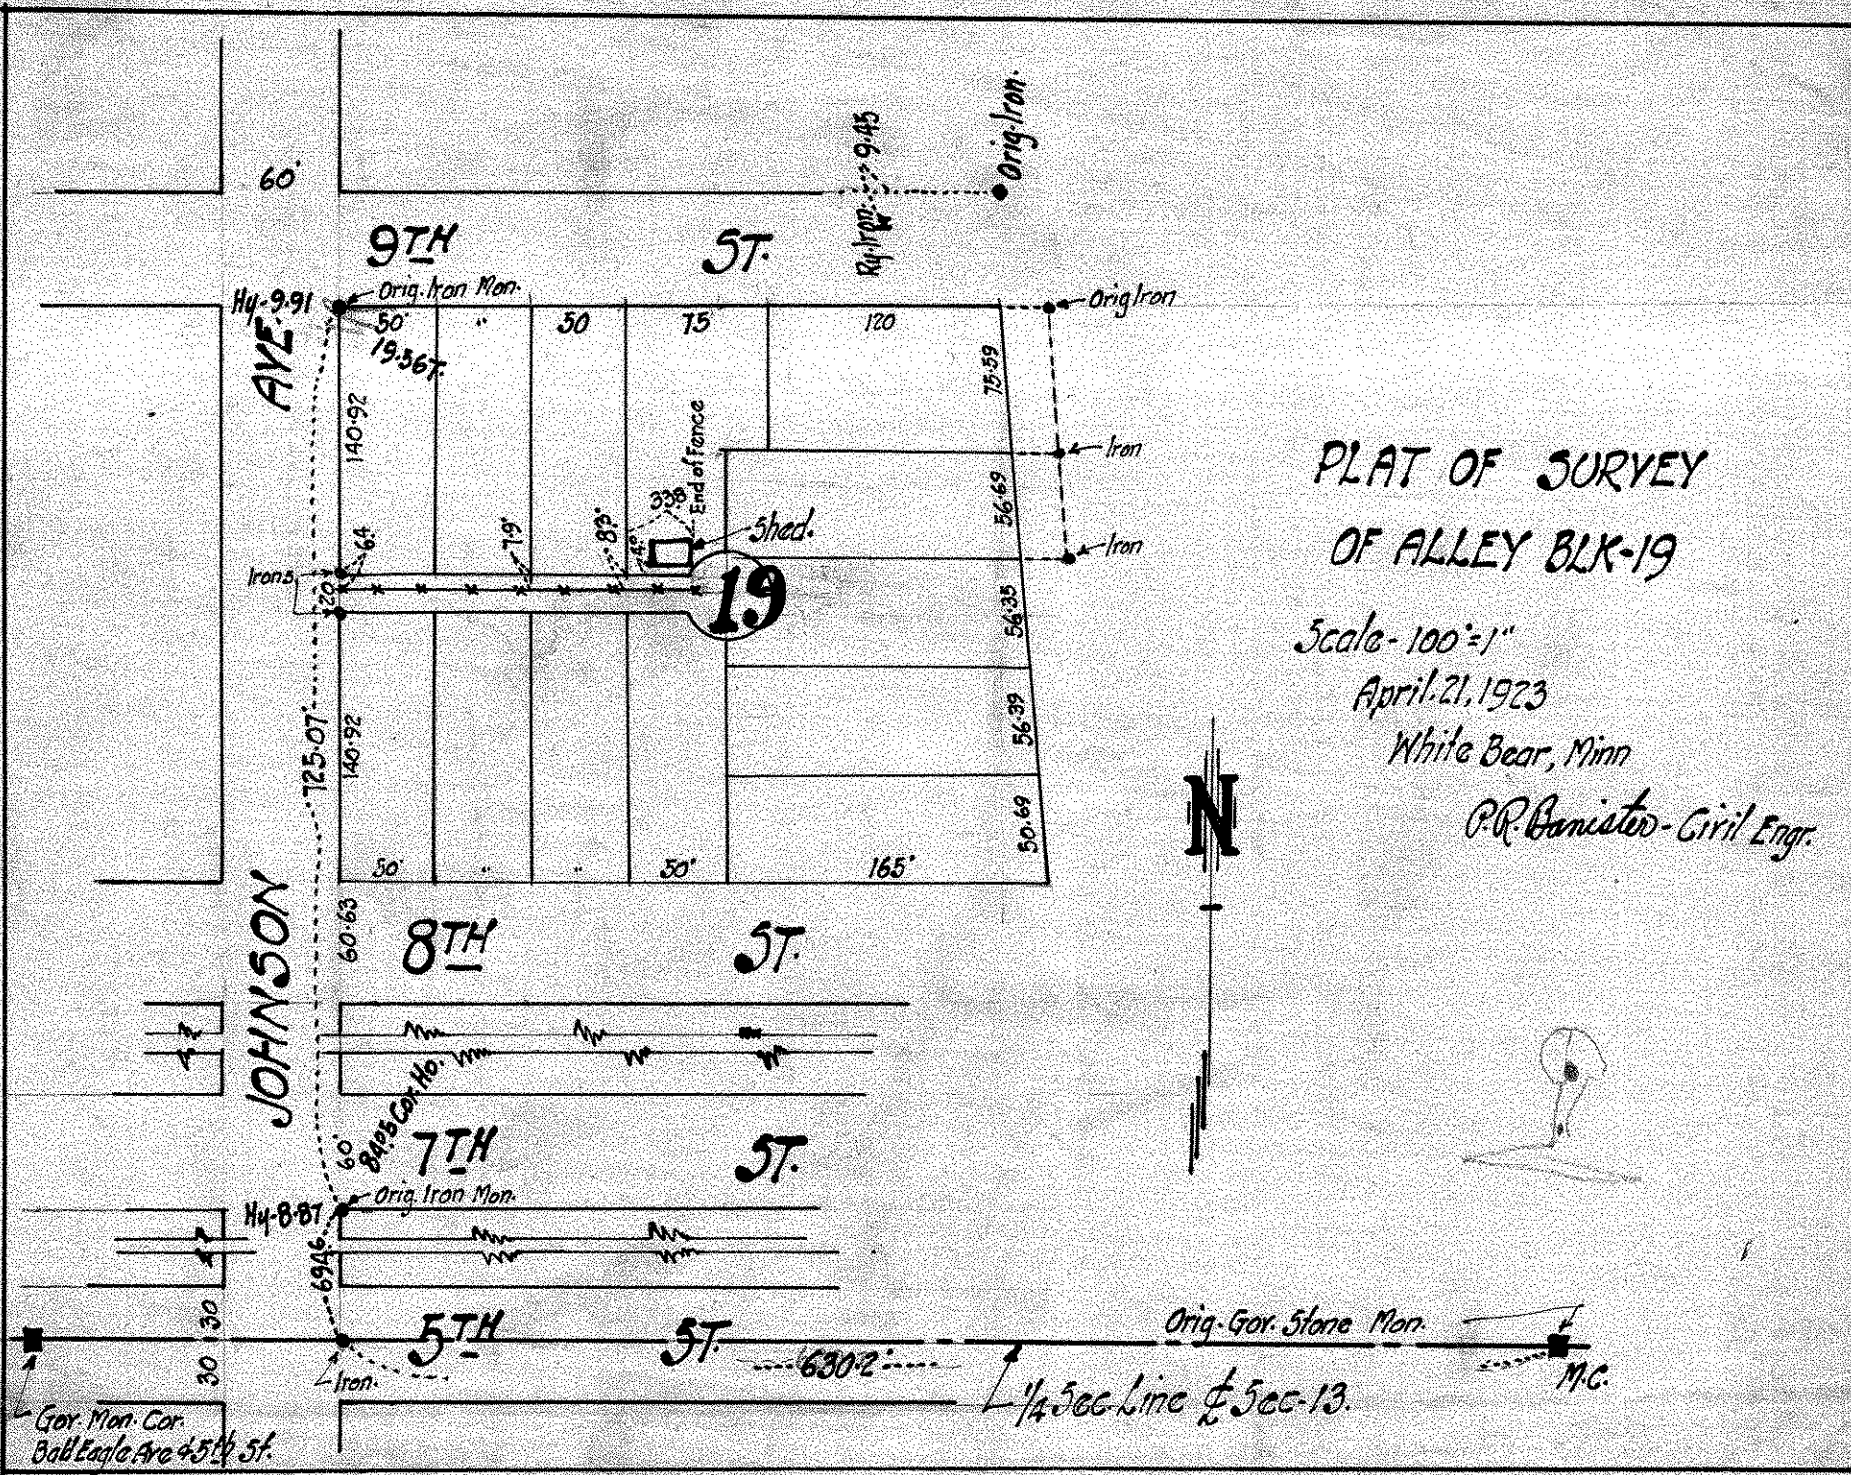


PLAT OF SURVEY
OF ALLEY BLK-19

Scale - 100' = 1"

April 21, 1923

White Bear, Minn

P.R. Barnister - Civil Engr.

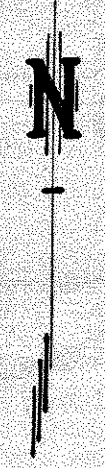

2-00-81-2