


AREAS AUSTIN'S ALLEY
OR PART OF WHITE BEAR

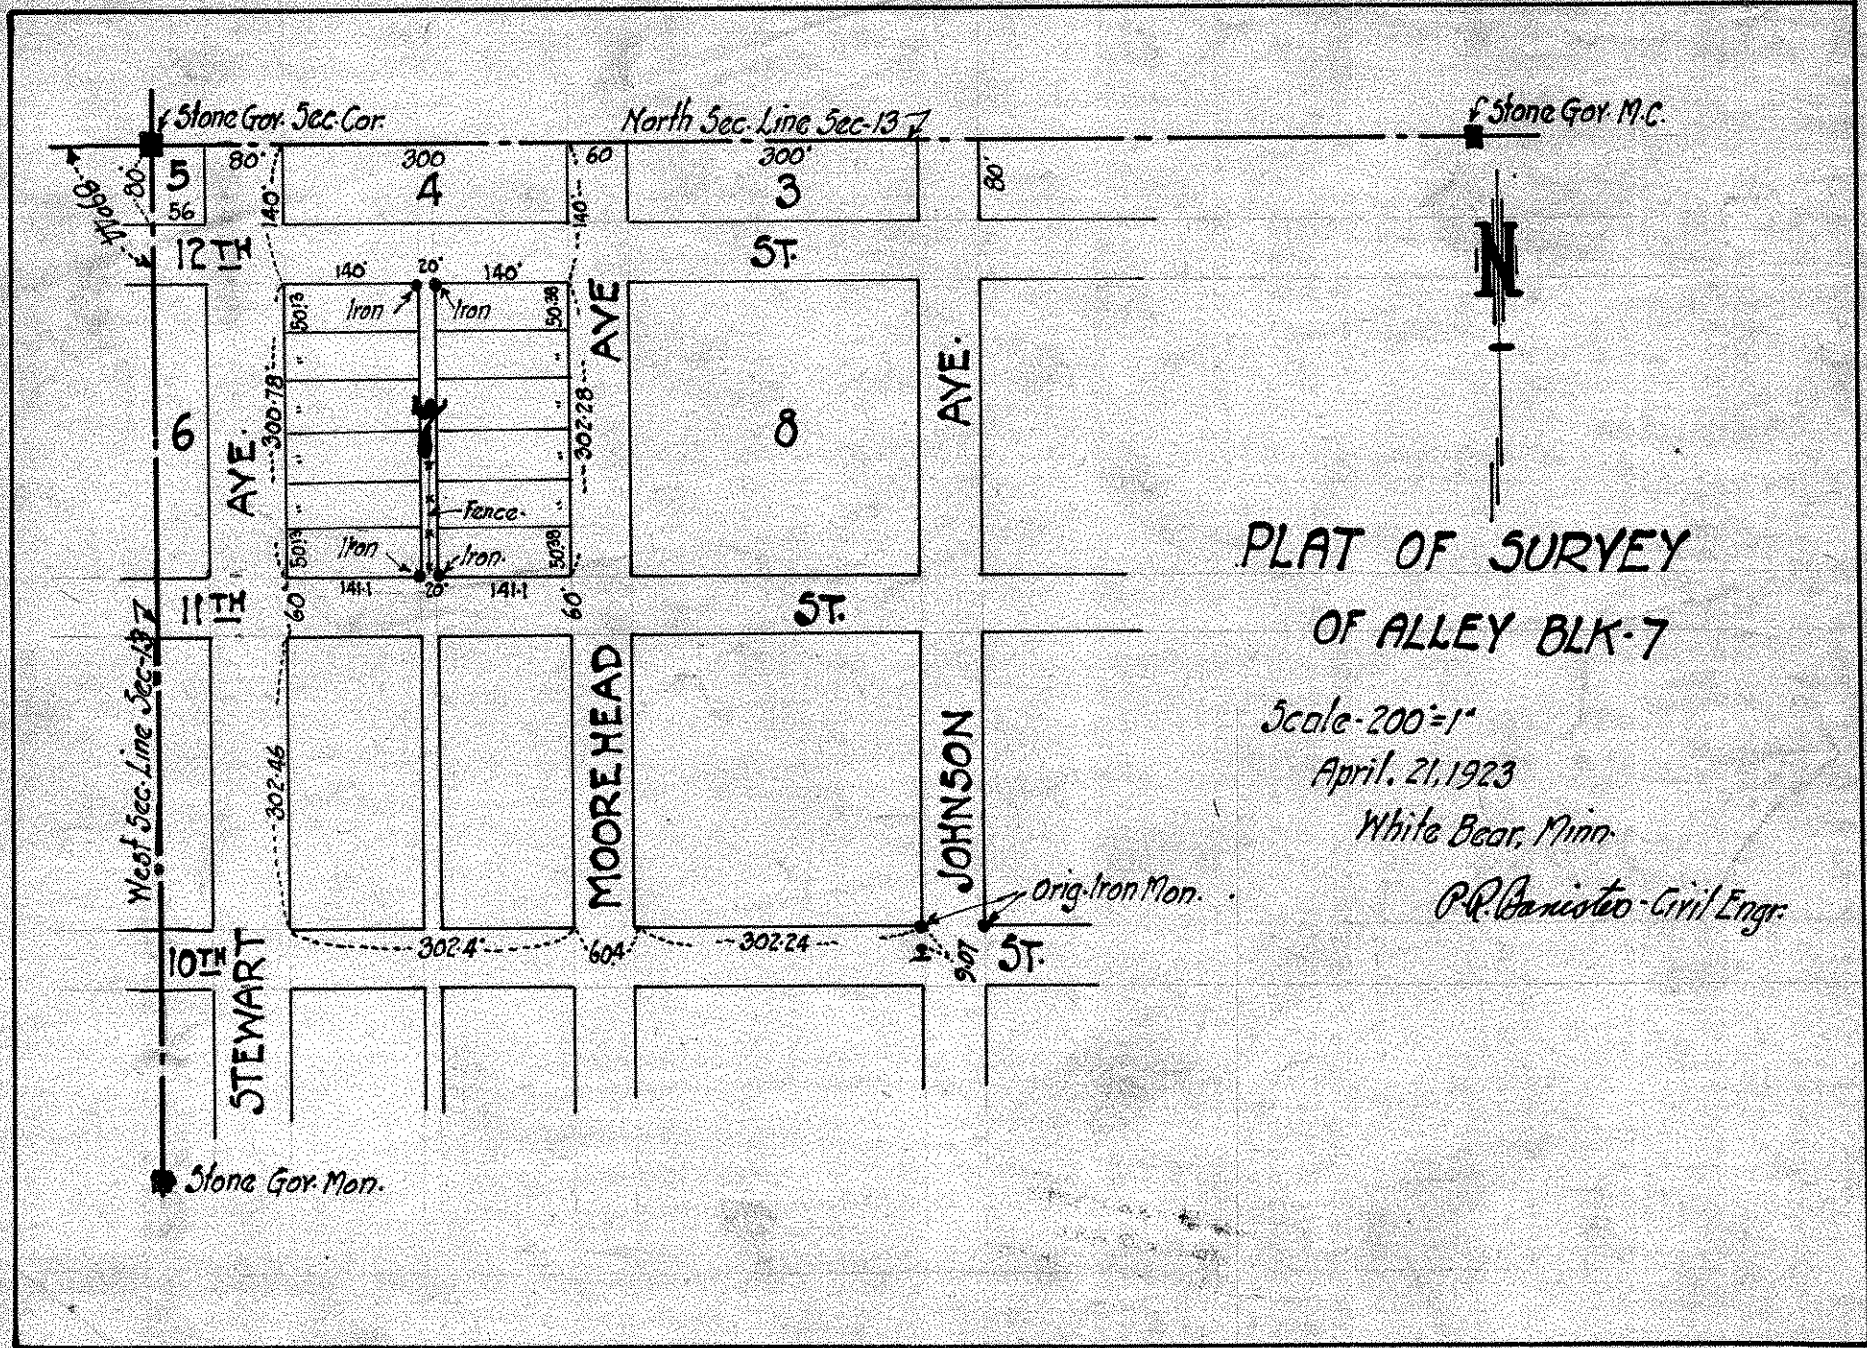

PLAT OF SURVEY
OF ALLEY BLK-7

Scale-200=1"

April. 21, 1923

White Bear, Minn.

P. R. Banister - Civil Engr.

12013-30-22