


FILE - SEC-26-30-22

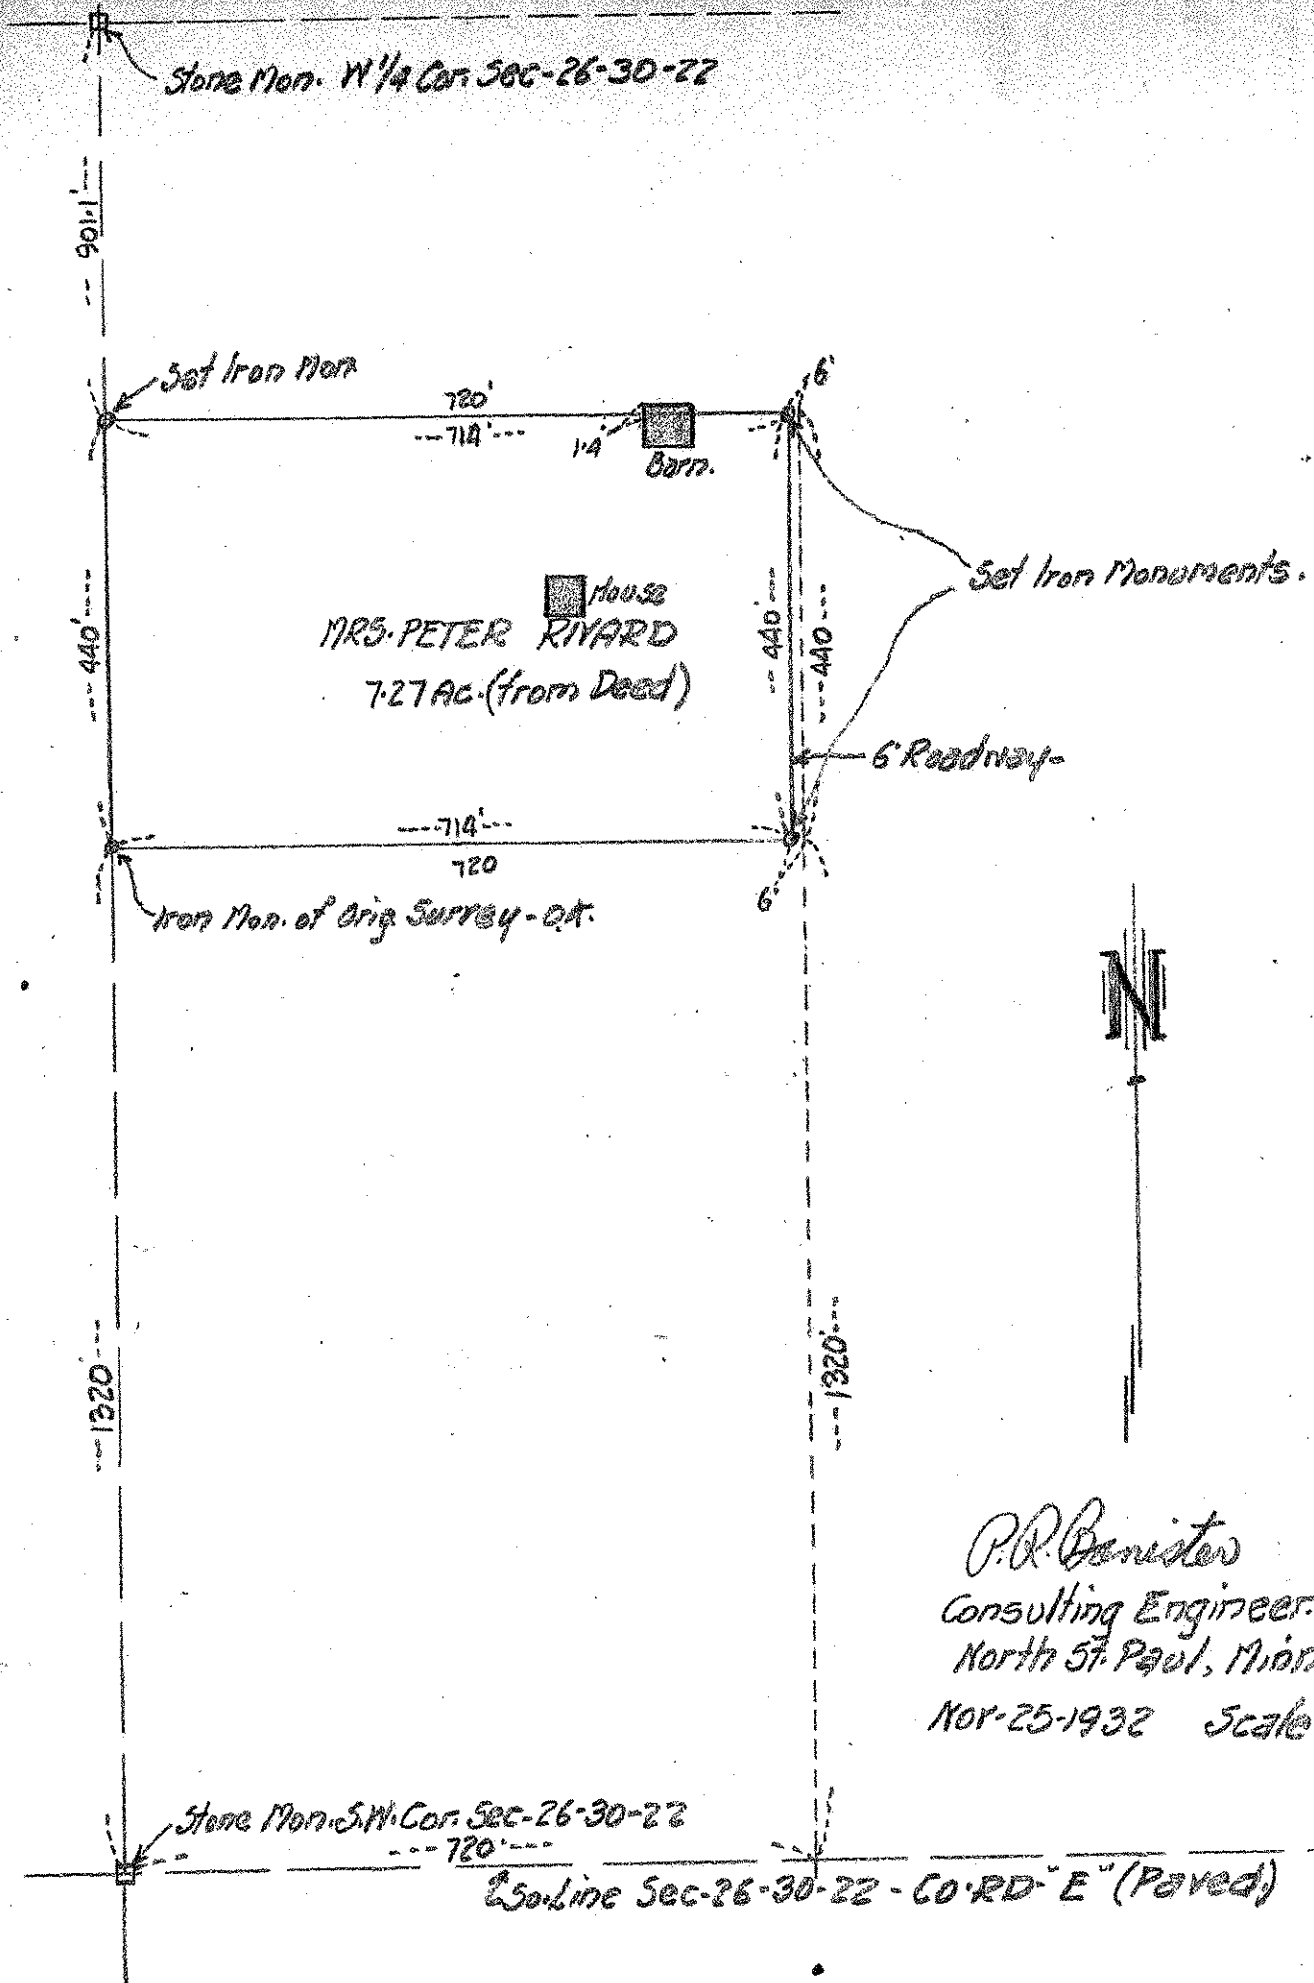

P. Q. Banister
Consulting Engineer.
North St. Paul, Minn.
Nov-25-1932 Scale - 1"=200'

250-Line Sec-26-30-22 - CO. RD. "E" (Paved)