

TELEPHONE 776-0640

PLAT OF SURVEY


OF PROPERTY OF Joseph Smaker

DESCRIBED AS FOLLOWS Lot 14, Auditor's Subdivision No. 78, Ramsey County, Minnesota, according to the plat on file and of record in the Office of the Register of Deeds in and for Ramsey County, Minn. No. 3765 Auger Ave, White Bear Lake, Minnesota.

SCALE: 1 INCH = 200 FEET

o DENOTES IRON

T. J. WELCH, REGISTERED SURVEYOR
701 EAST 3RD STREET, ST. PAUL, MINN. 55106

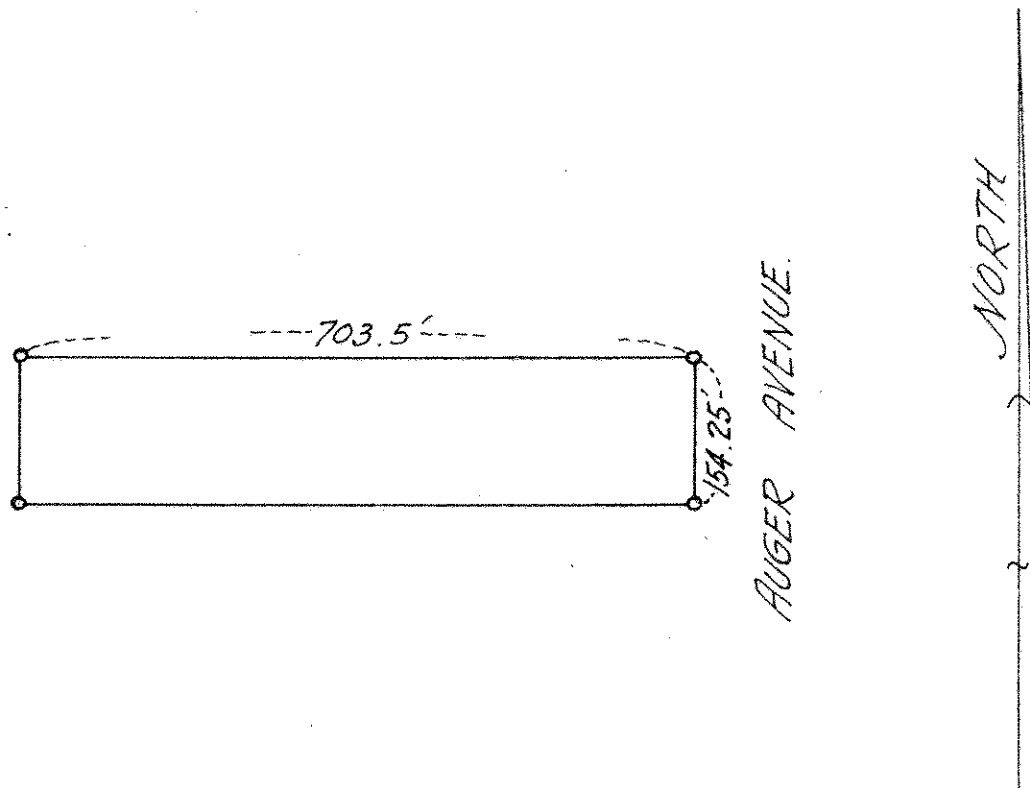

CERTIFICATE OF SURVEY

I hereby certify that on August 30, 1967
I surveyed the property described above and that the above
plat is a correct representation of said survey.

J. J. Welch