

FROM THE OFFICE OF

CHARLES O. GEORGI COMPANY

2215 West County Road B

Saint Paul, Minnesota 55113

REGISTERED CIVIL ENGINEER AND LAND SURVEYOR

Certificate of Survey

I Hereby Certify that this plat shows a survey made by me of the property described on this plat, and that the corners are correctly placed as shown, and that all locations have been correctly shown.

Surveyed For Kenneth W. Bacchus


Date March, 1971

Scale 1" = 50'

By Charles O. Georgi
REGISTERED LAND SURVEYOR

Description:

The South 100 feet of the North 208.71 feet,
of the East 208.71 feet of lot 1,
Auditors Subdivision No. 78, subject to
Highland Ave. on the Easterly 33 feet thereof,
Ramsey County, Minnesota.

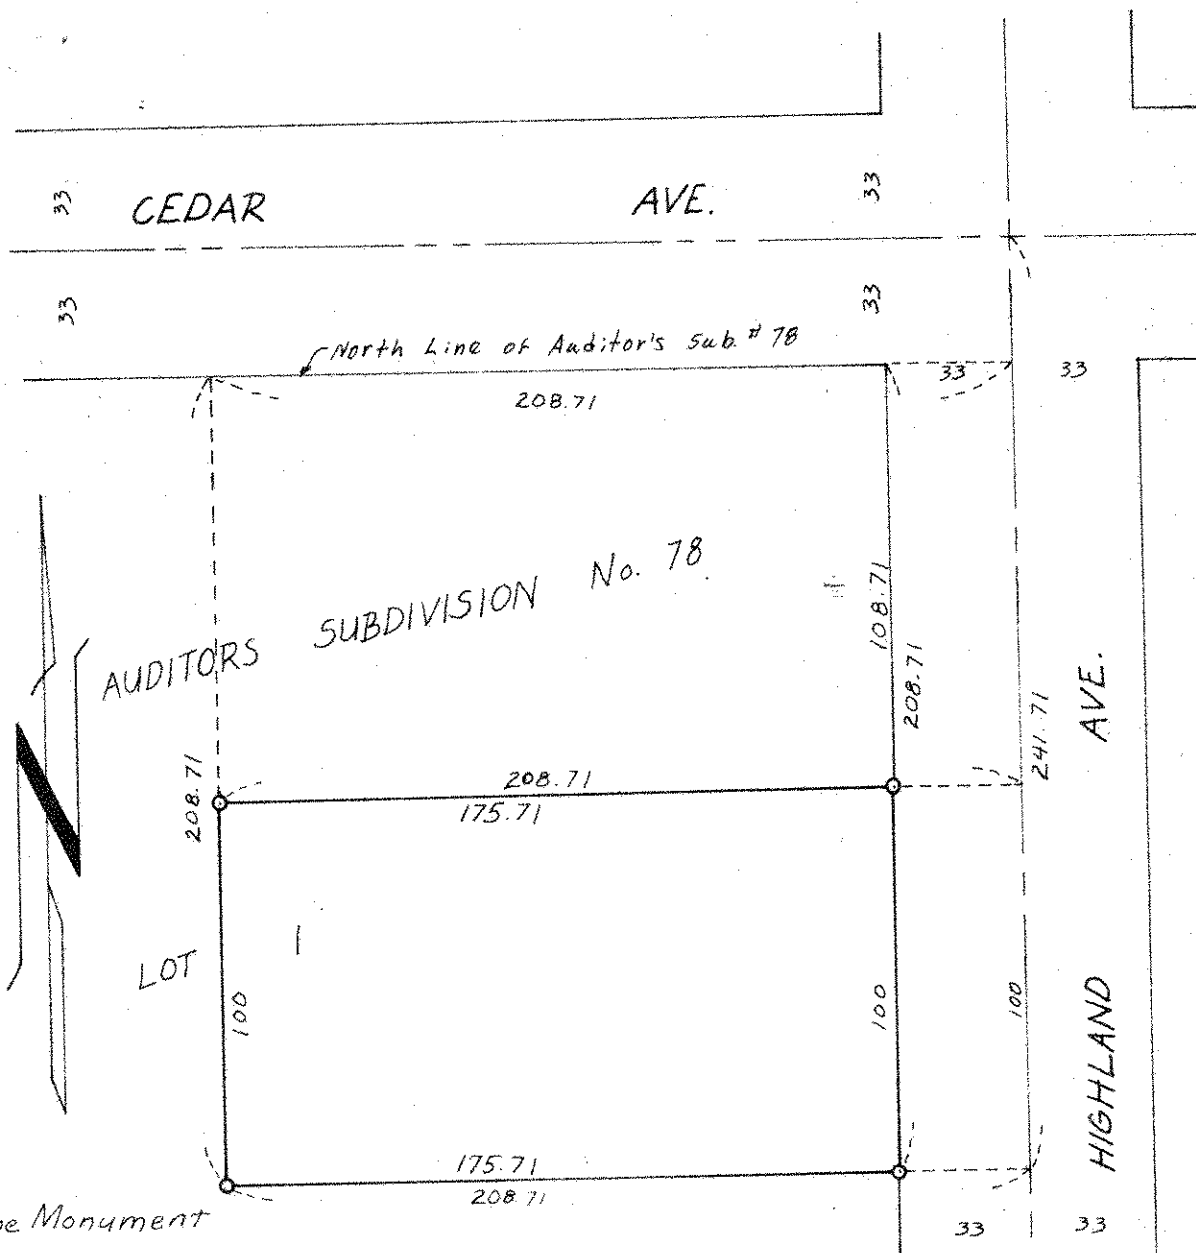

○ Denotes Iron Pipe Monument