SW 26 30 22

Certificate of Survey

From the office of

GEORGI- SCHMIDT & ASSOC. INC.

3092 No. Lexington Ave., Roseville, Mn. 55113

LAND SURVEYING

483-4408

I Hereby Certify that this plat shows a location survey made by me of the property described on this plat, ~~and that the corners are correctly placed as shown~~, and that all locations have been correctly shown.

Job Number: _____

Surveyed For Kenneth W. Bacchus Inc.

Date January 9-1979


By Donald W. Schmidt
REGISTERED LAND SURVEYOR

Description:

Surveyed according to description furnished which calls for North line to be 1760 North of and parallel to south line of Section. (refer to Warranty Deed dated June 4, 1958 - Filed Sept 18-1958 in Book 1588, RCR page 533 - file # 1465133)

This agrees with enclosed survey by P.R. Bemister dated Nov 25-1932

Welch survey of August 30-1967 does not tie Lot lines to Section lines.
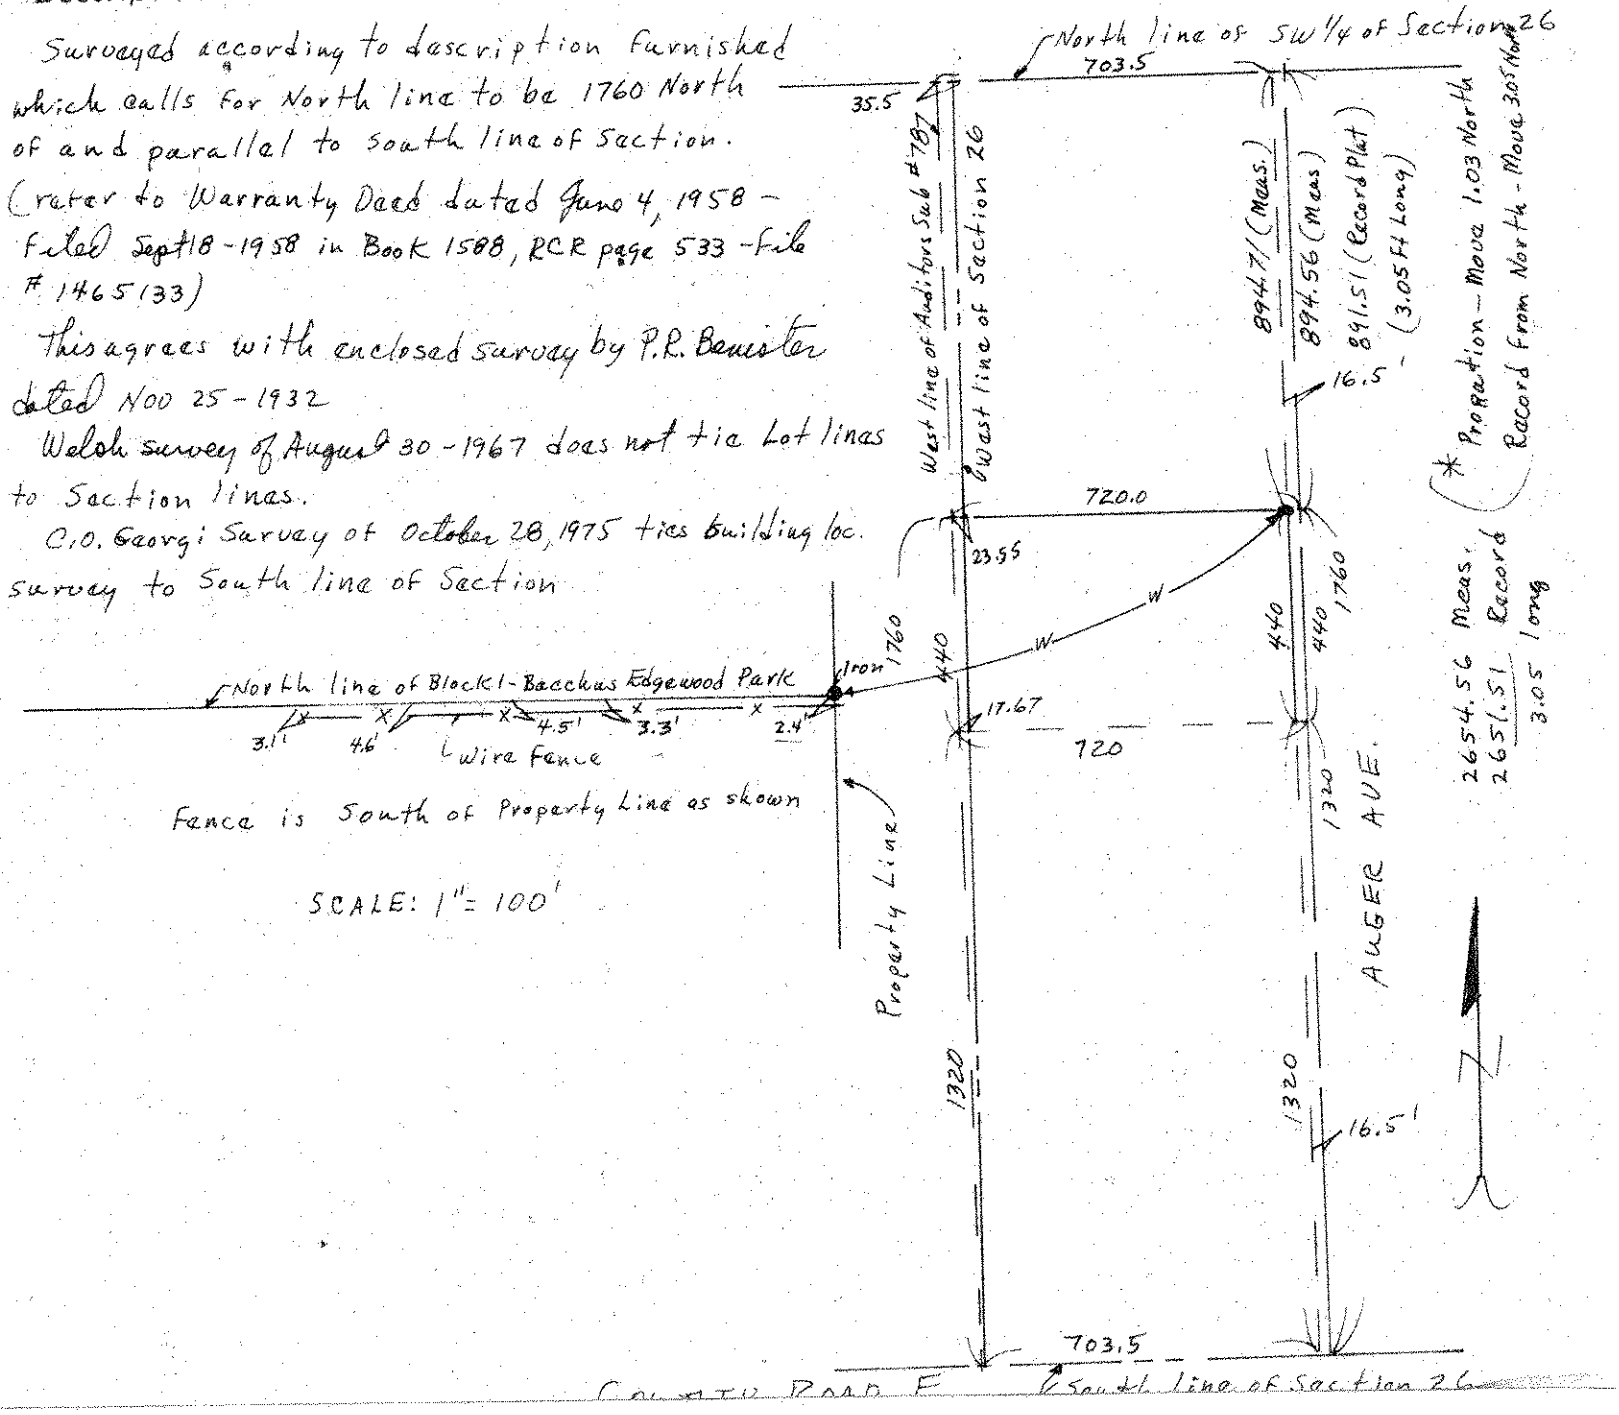
C.O. Georgi Survey of October 28, 1975 ties building loc. survey to South line of Section