

14 30 22

FROM THE OFFICE OF

CHARLES O. GEORGI COMPANY

2215 West County Road B

Saint Paul, Minnesota 55113

REGISTERED CIVIL ENGINEER AND LAND SURVEYOR

Certificate of Survey

I Herby Certify that this plat shows a survey made by me of the property described on this plat, and that the corners are correctly placed as shown, and that all locations have been correctly shown.

Surveyed For Paul Silverberg

Date October 1976

Scale 1"=40'


By Charles O. Georgi
REGISTERED LAND SURVEYOR

Description:

Lot 12, except the North 100 Feet thereof,
Block 3, Auditor's Subdivision No. 48.

Ramsey County, Minnesota

Surveyor's Notes:
(R) Denotes Record Plat distance
(P) Denotes prorated distance
(M) Denotes measured distance to irons
and line of occupancy as found in field.

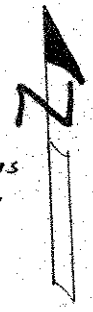

○ Denotes Iron Monument
● Denotes Iron Found in place

