


Chuck,

Phase check this house for location on
 the lot for Veterans Administration. SIGN +
 Return 2 copies _____ Nash.

LO
 33.85
26.15
 43.25
13.07
 30.18

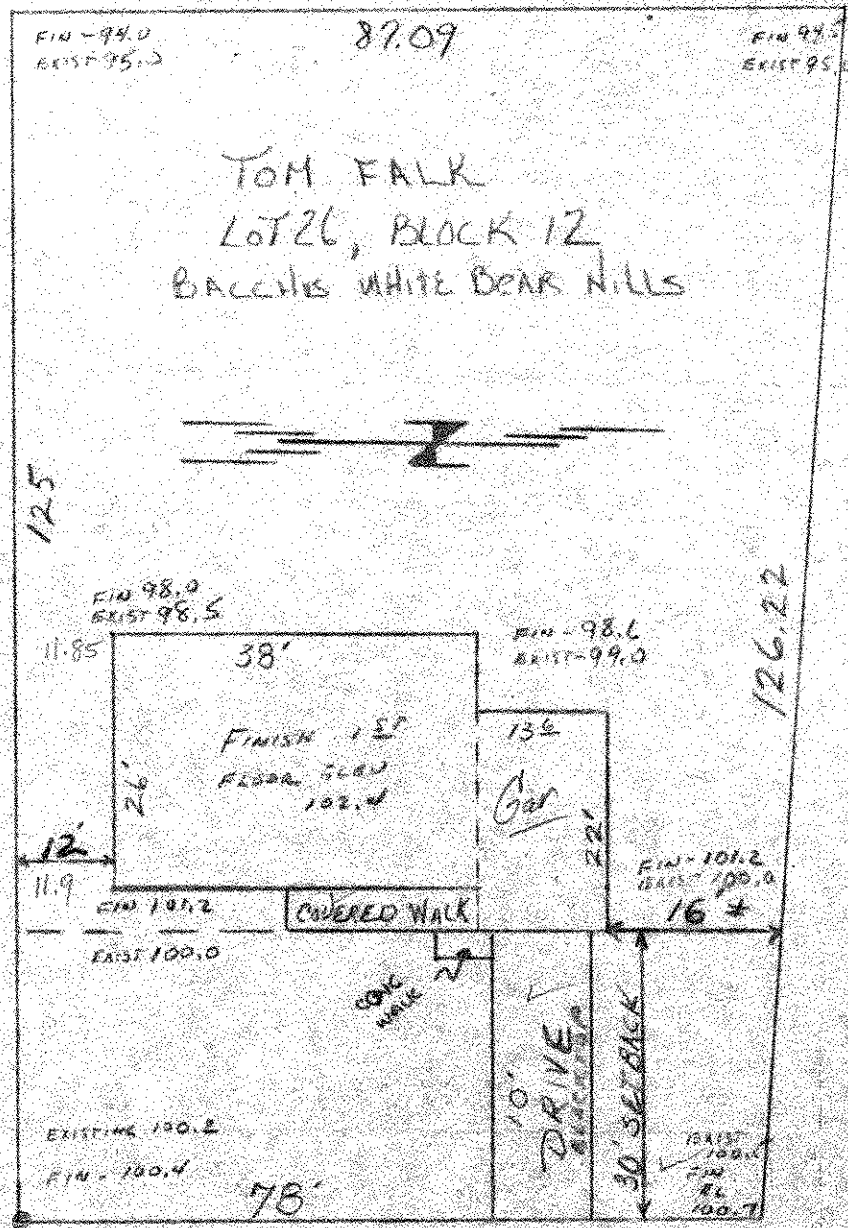

— 3701 SUN TERRACE —

EL 100.0

EL 100.3

PLOT PLAN

SEWER INVERT
 90.5