


Bald Eagle
Apr 9-09

SHORT ST
541.08

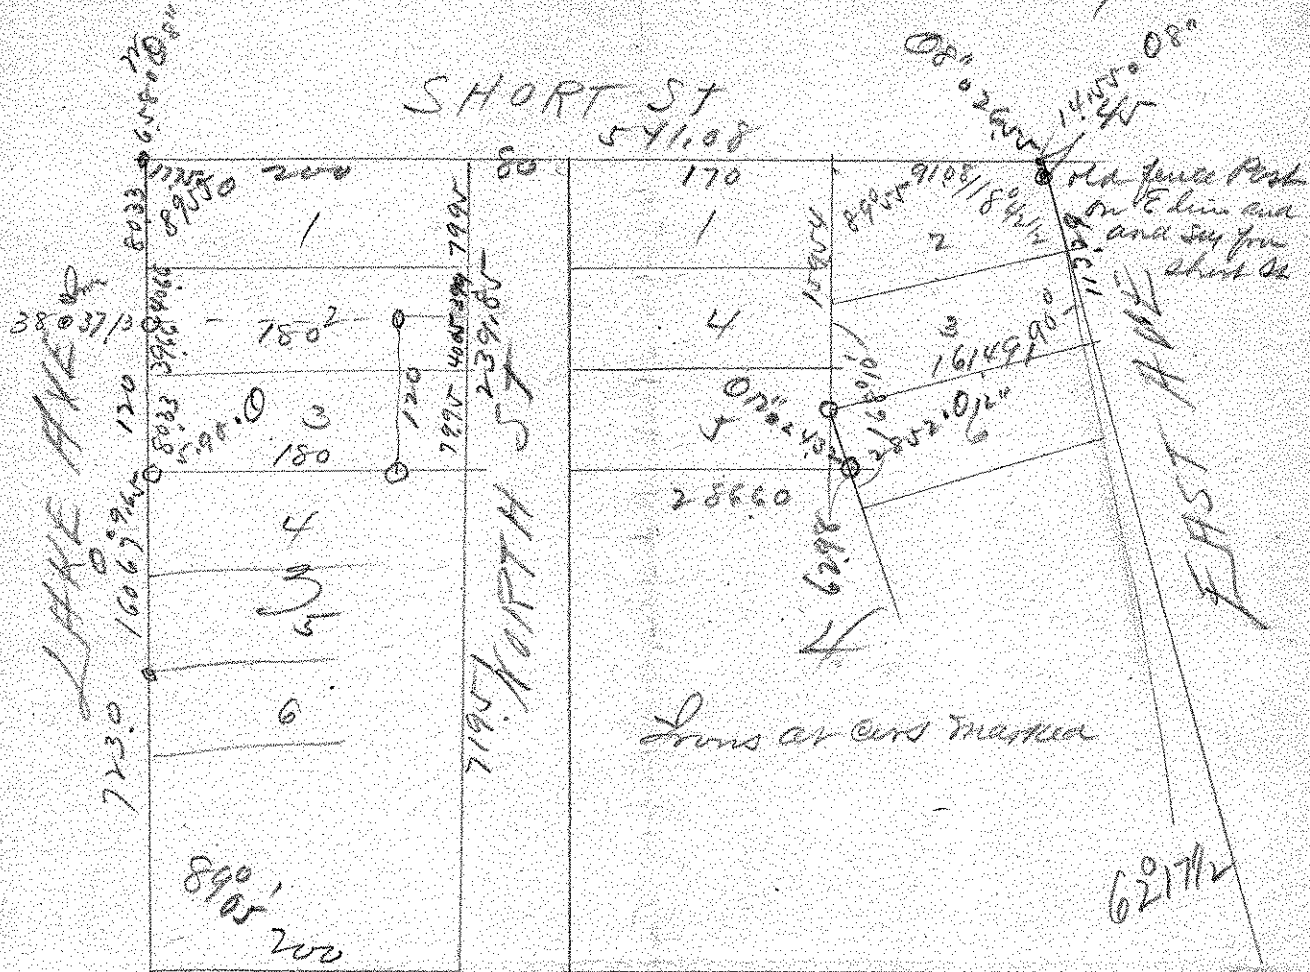

Iron or cur marked

PARK ST

Survey for A. L. Haman

Apr 5 - 1909

Murray
Stokes
Clark
Hawley