30 22

FROM THE OFFICE OF

CHARLES O. GEORGI COMPANY

2215 West County Road B Saint Paul, Minnesota 55113

REGISTERED CIVIL ENGINEER AND LAND SURVEYOR

Certificate of Survey

I Hereby Certify that this plat shows a survey made by me of the property described on this plat, and that the corners are correctly placed as shown, and that all locations have been correctly shown. Corners placed November 1960. 4/15/71 Combined drawing made from old survey

Surveyed For HAROLD C. HANSON

Date April 15, 1971

Scale 1" = 50'

By Charles O. Georgi
REGISTERED LAND SURVEYOR

Description:
The North 80 feet of the East 210 feet of Lot 2, Block 7, Rearrangement of White Bear Park Ramsey County, Minn.

Description:
The South 80 feet of the North 160 feet of the East 210 feet of Lot 2, Block 7, Rearrangement of White Bear Park, Ramsey County, Minn

Description:
The East 210 feet of Lot 2, Block 7, Rearrangement of White Bear Park except the North 160 feet thereof, Ramsey County, Minn.

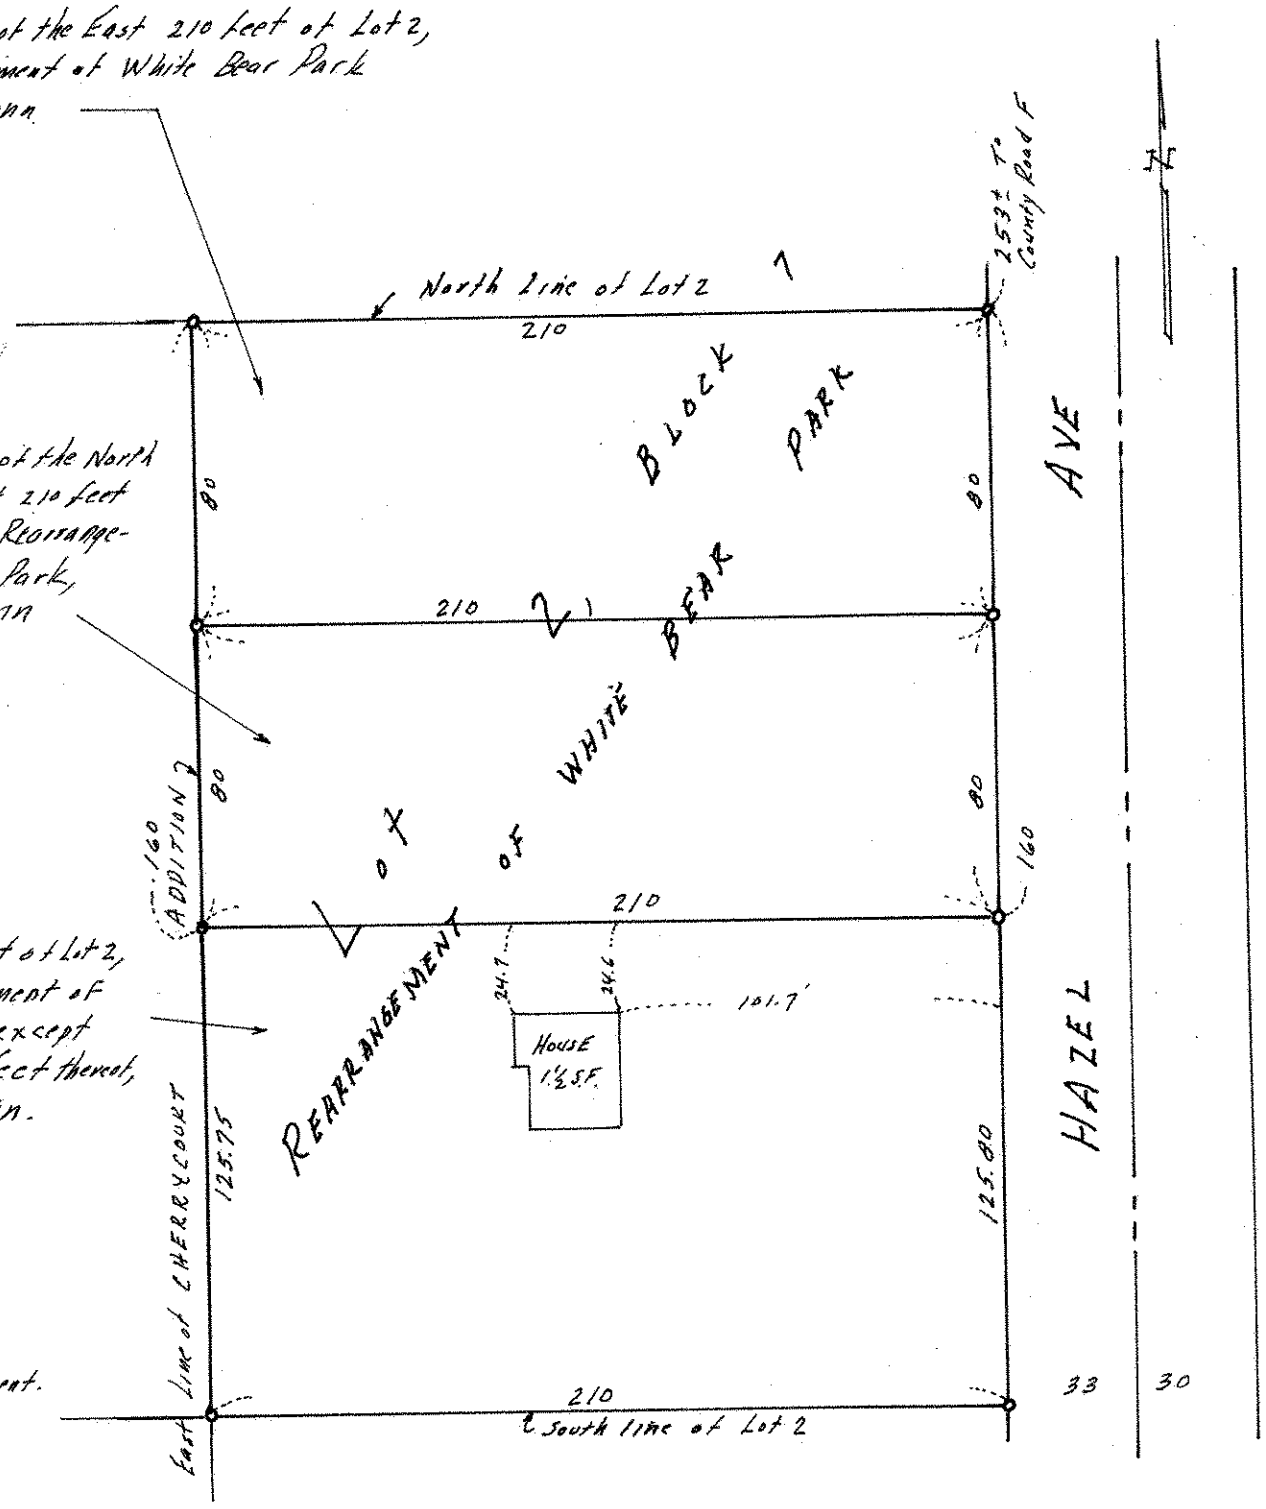

o Denotes Iron Monument.