

GOMSTOCK AND DAVIS INC.

3092 N. LEXINGTON AVE. ST. PAUL, MN. 55113 483-4408


SURVEY FOR: Joan Bendickson

DESCRIPTION: Lots 16 and 17 and the North 1/2 of Lot 15, Block 2,
Bacon & Coleman's Rice Street Acre Lots, Ramsey County, Minn.



SCALE: 1" = 60'

o Denotes Iron Pipe Monument set.

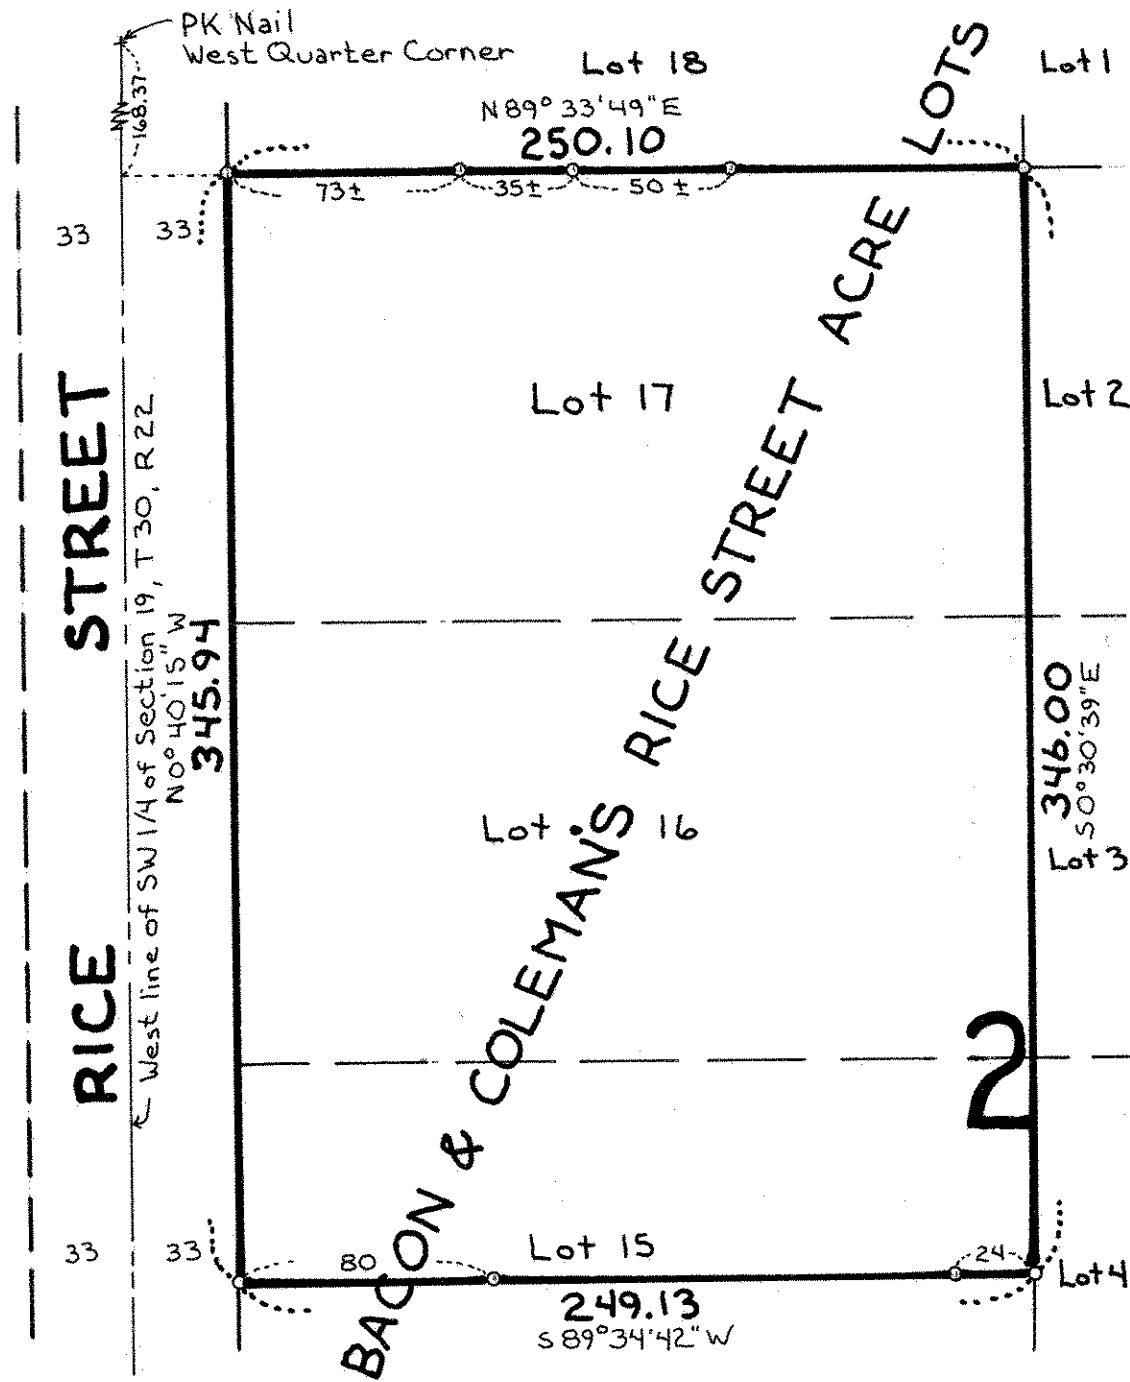

I hereby certify that this survey, plan plat, preliminary plat or report was prepared by me or under my direct supervision and that I am a duly Registered Land Surveyor under the laws of the State of Minnesota.

Donald W. Schueller

10459
Reg. No.

11/10/92
Date

R-92880
Job No.

Book No.