


# GOMSTOCK AND DAVIS INC.

SURVEYED FOR: Greg Steeber

Computed 1/4 corner

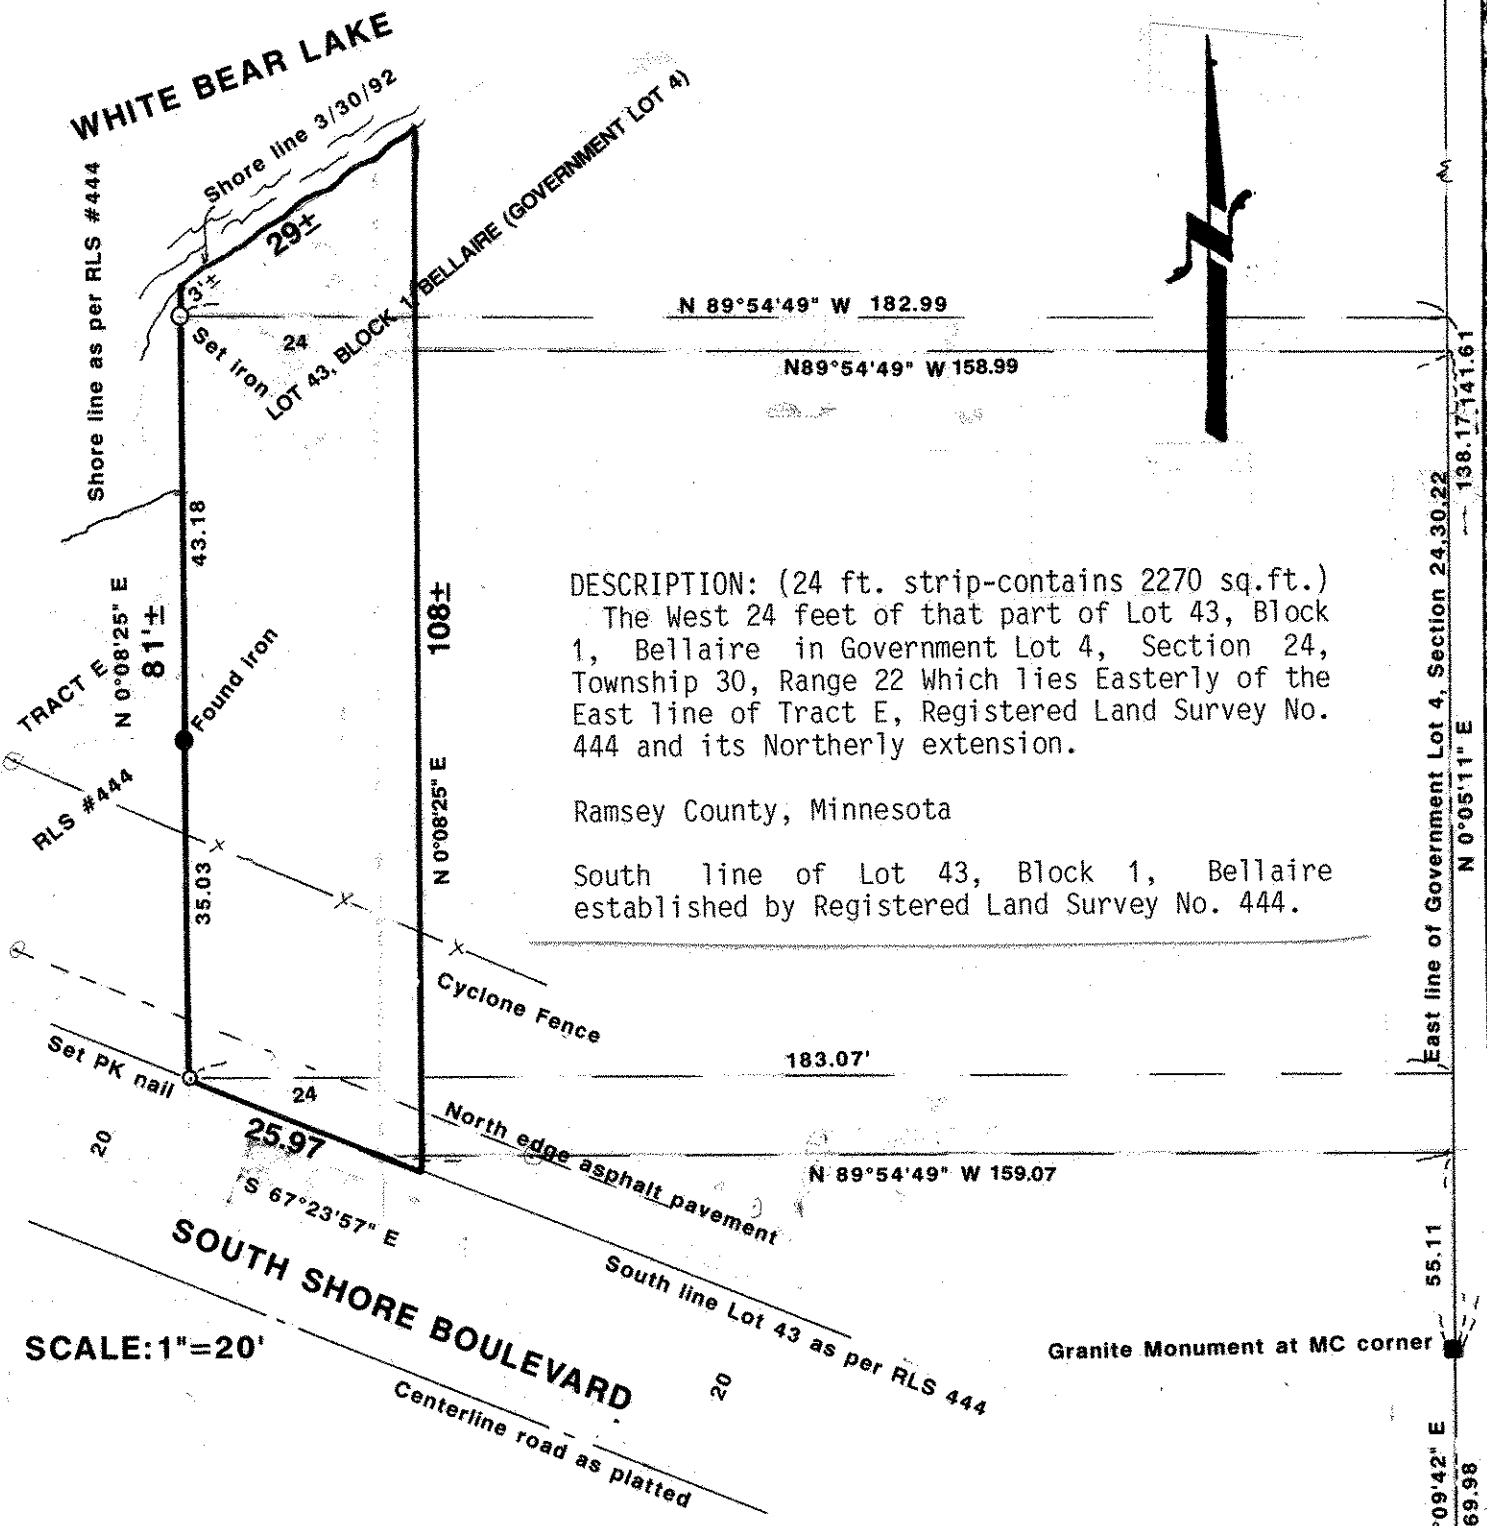

DESCRIPTION: (24 ft. strip-contains 2270 sq.ft.)  
 The West 24 feet of that part of Lot 43, Block 1, Bellaire in Government Lot 4, Section 24, Township 30, Range 22 Which lies Easterly of the East line of Tract E, Registered Land Survey No. 444 and its Northerly extension.

Ramsey County, Minnesota

South line of Lot 43, Block 1, Bellaire established by Registered Land Survey No. 444.

SCALE: 1"=20'

I hereby certify that this survey, plan plat, preliminary plat or report was prepared by me or under my direct supervision and that I am a duly Registered Land Surveyor under the laws of the State of Minnesota.

*Dwight L. Russell* 10459 4/10/92 4/2/92 R-92761  
 Reg. No. Date Job No. Book No.