

GOMSTOCK AND DAVIS INC.

3092 NORTH LEXINGTON AVE., ST. PAUL, MN 55113 (612) 483-4408

SURVEYED FOR : Robert Wilson

DESCRIPTION: (Total)

Lots 13 and 14, Hedman's Lakeside. Ramsey County, Minnesota


DESCRIPTION: (Parcel "A"-contains 7370 sq.ft.)

The North 117 feet of the West 63 feet of Lot 13, Hedman's Lakeside. Ramsey County, Minnesota

DESCRIPTION: (Parcel "B"-contains 16430 sq.ft.)

Lot 13, except the North 117 feet of the West 63 feet thereof, and all of Lot 14, Hedman's Lakeside. Ramsey County, Minnesota

o Denotes iron pipe monument set Easements as per final plat

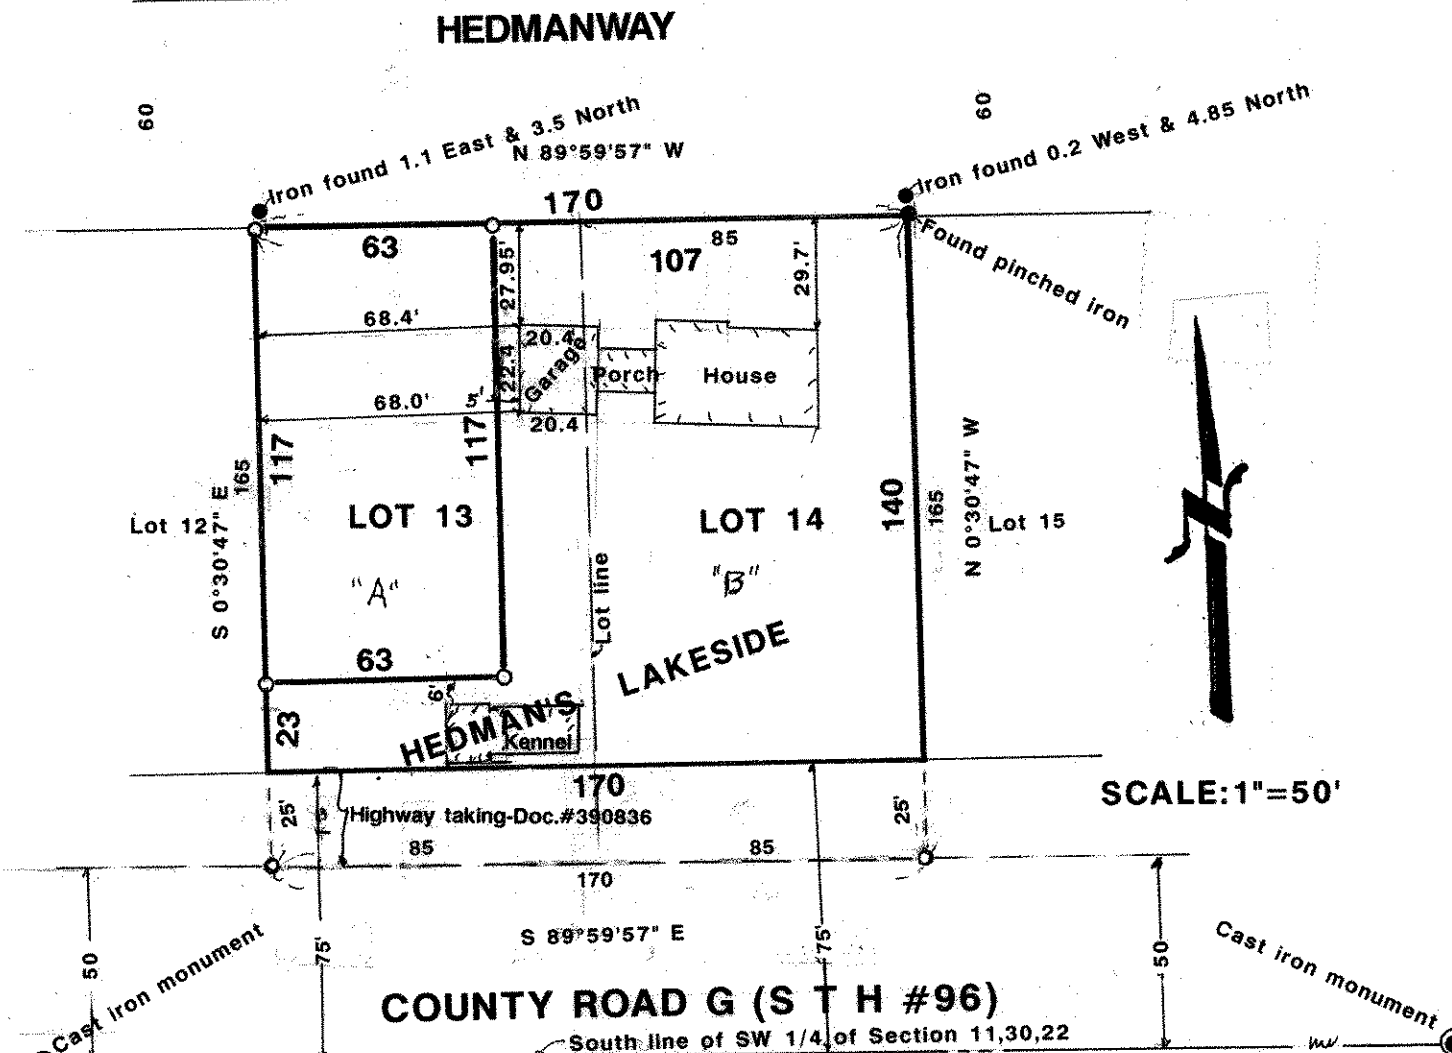

I hereby certify that this survey, plan plat, preliminary plat or report was prepared by me or under my direct supervision and that I am a duly Registered Land Surveyor under the laws of the State of Minnesota.

Donald L. Schaub

10459
Reg. No.

4/7/92
7/1/92
Date

R-92766
Job No.

Book No.