


DESCRIPTION:
 All of the SE 1/4 of the NE 1/4 of Section 36, T30N, R22W, and all of the NE 1/4 of the SE 1/4 of Section 36, T30N, R22W, except the North 295 feet of the East 295 feet thereof.

NOTES:
 All elevations are U.S.G.S. Datum.
 B.M. 1017.38 Top hyd north of Glen Oaks 200' south of P.C. on West side of Crestline Drive.
 B.M. 1022.36 Top hyd SW corner of Crestline Drive and Glen Oaks Ave.
 B.M. 1003.28 spike in power pole on Century Ave north of cemetery entrance.
 B.M. 1031.11 spike in power pole No. 141 on Century Ave.

P.P. Denotes Power Pole
 T.P. Denotes Telephone Pole
 33.1 Denotes elevation 1031.1
 O Denotes Iron Monument

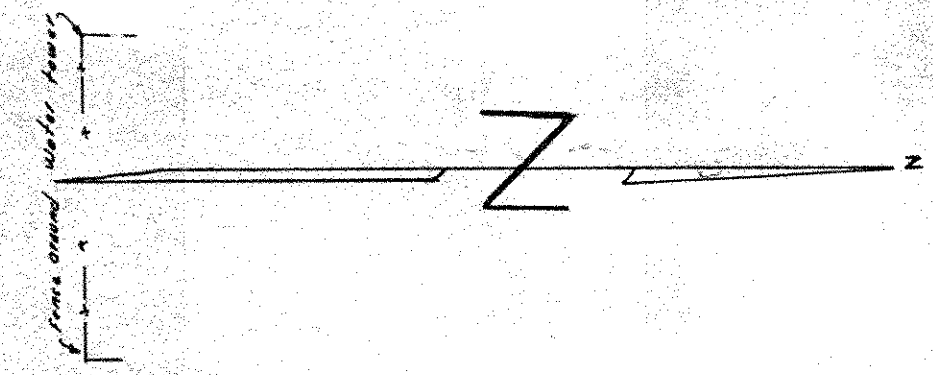

SITE MAP
 LAKEWOOD STATE JUNIOR COLLEGE
 CITY OF WHITE BEAR LAKE
 RAMSEY COUNTY, MINN.

SCALE 1"=100'

Mailed points on 12/9/47
 12/12/47
 1/4/48
 1/7/48
 3/10/48

9.14.0
 9046.50
 7.20

1318.51
 - 87
 1318.48

Charles O. Geary Company
 Civil Engineer and Land Surveyor
 2215 W. County Rd. B. St. Paul, Minn.