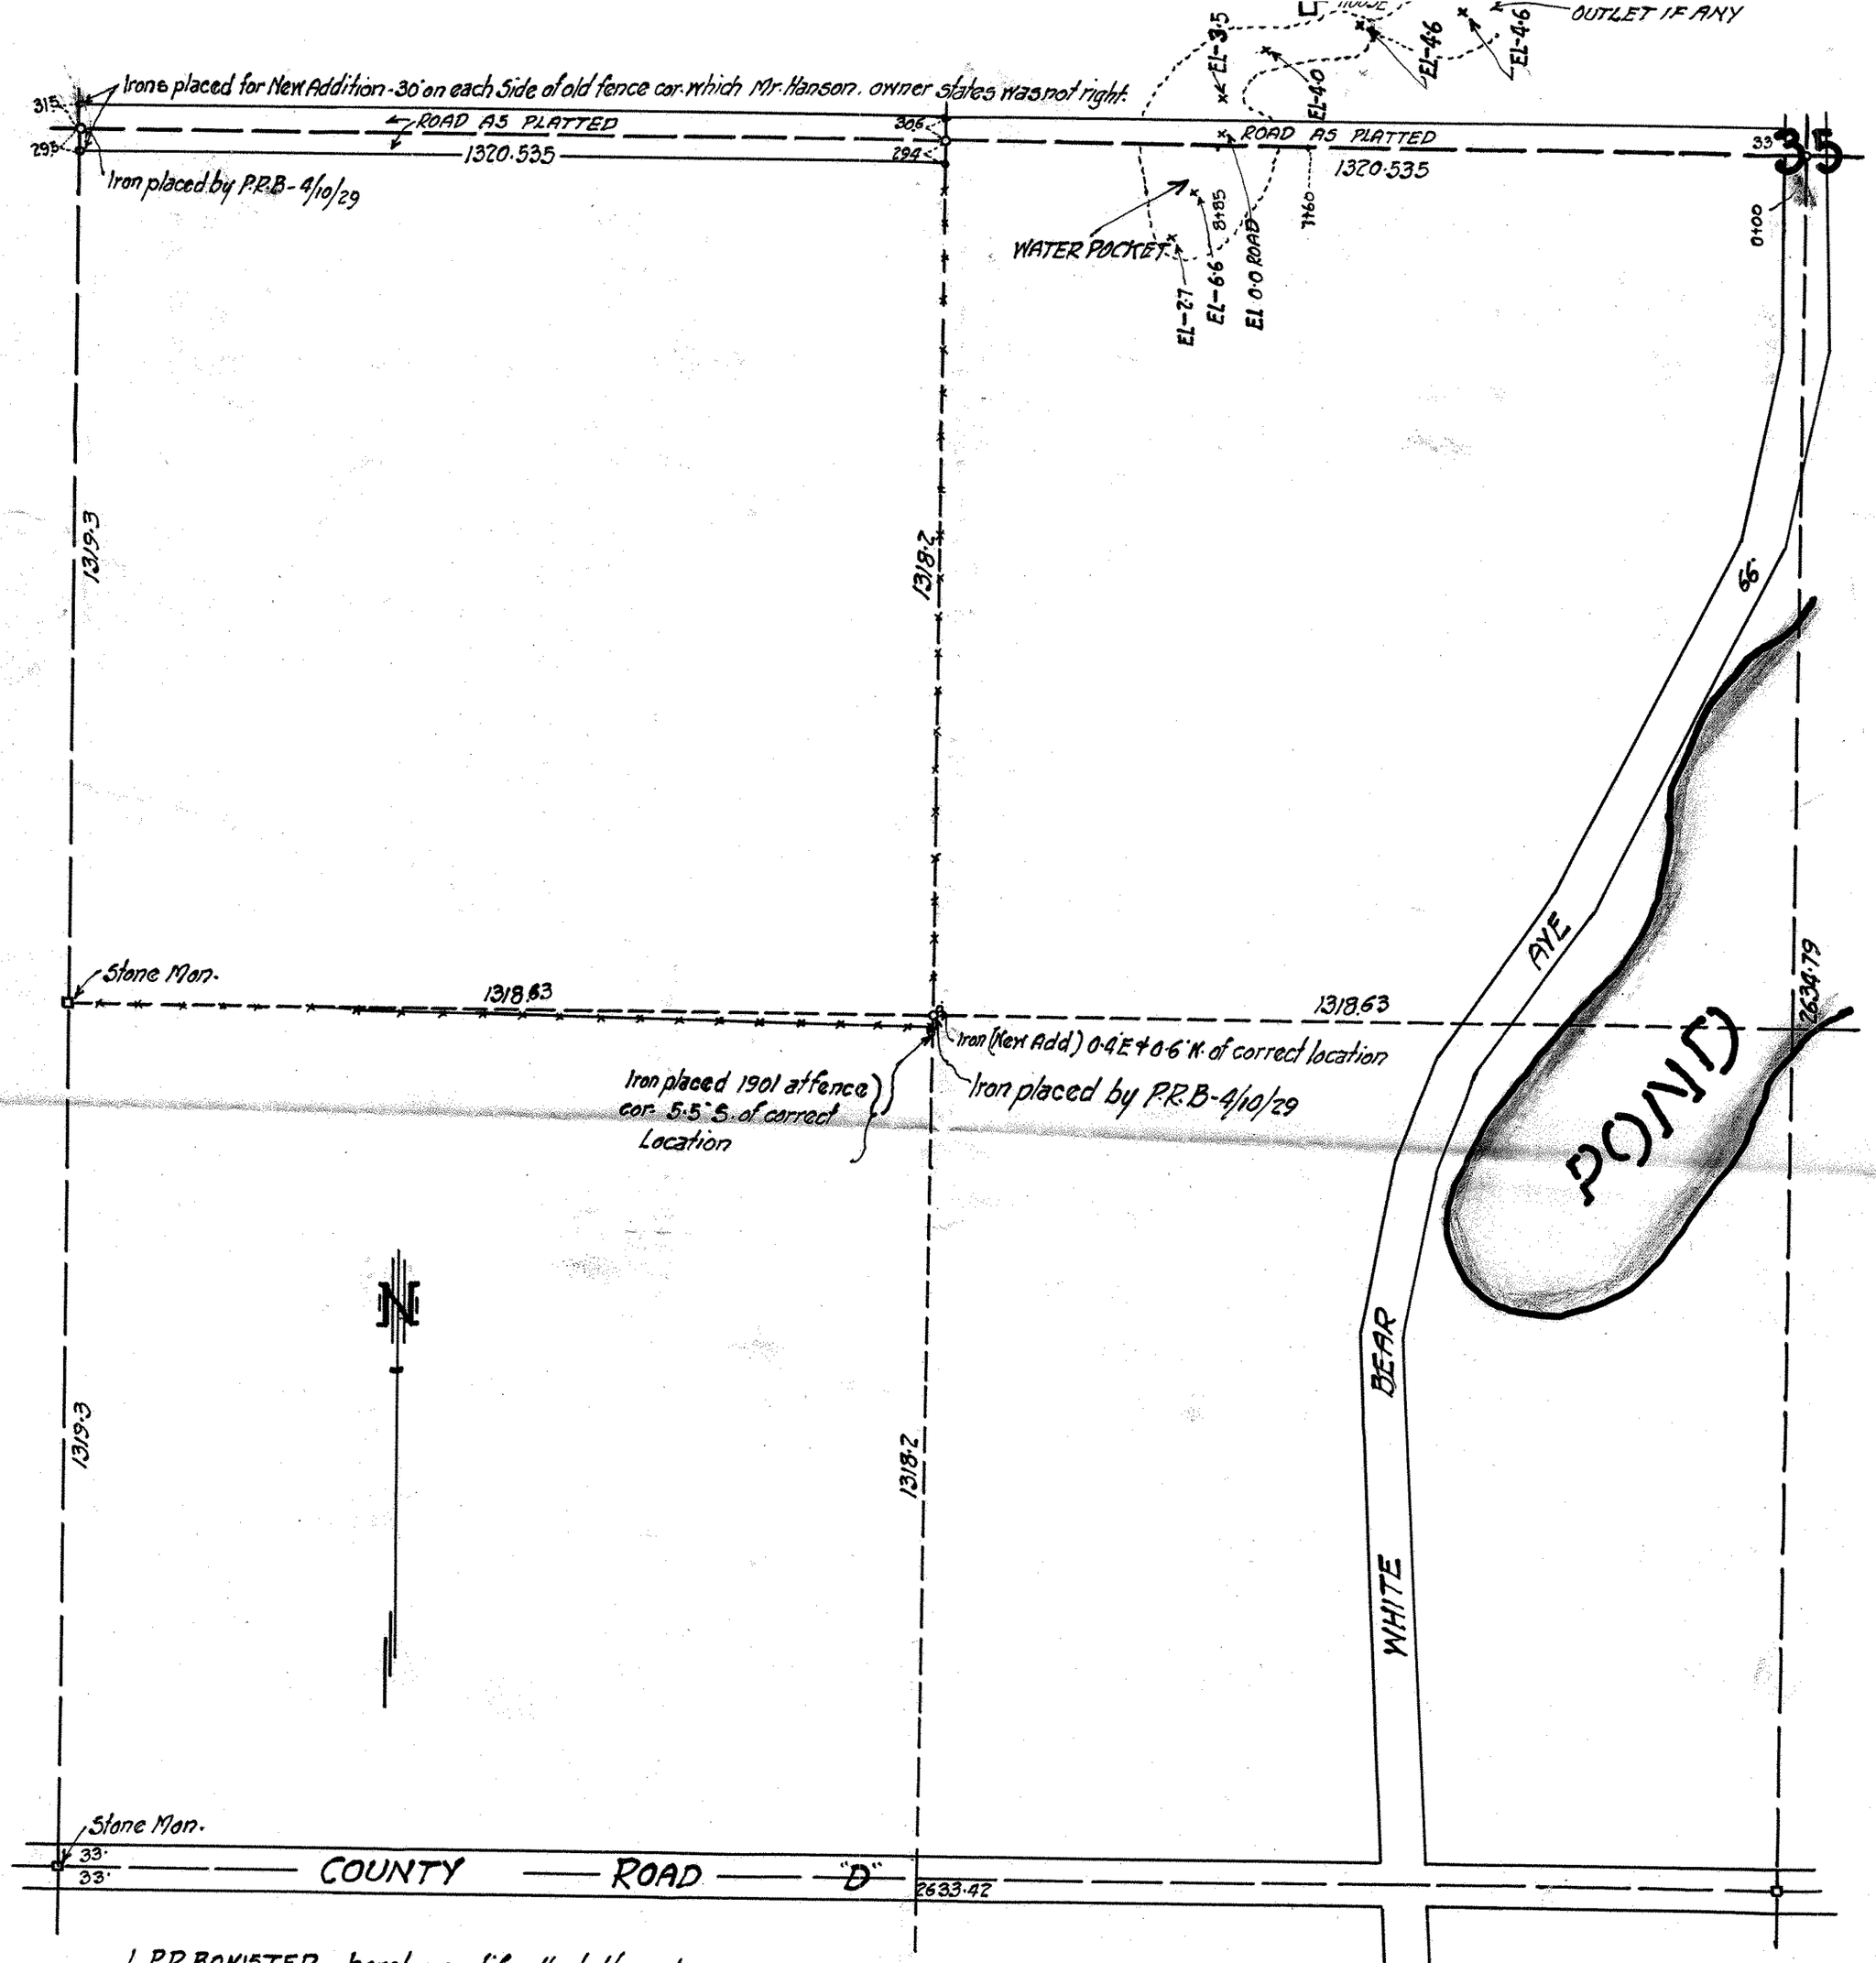

I, P.R. BANISTER, hereby certify that the above plat represents correctly survey made by me April. 10, 1929

P.R. Banister.

SURVEY IN SW 1/4, SEC-35, T-30-N, R-22-W
FOR JOHN HANLOS

P.R. BANISTER - REGISTERED PROFESSIONAL ENGINEER
69-7th AVE. NORTH ST. PAUL, PHONE NSP-407
SCALE 1" = 200'