

JOHN B. LITTLE
ENGINEER AND SURVEYOR
ROOM 418 GLOBE BLDG.
COR. FOURTH AND G ST.



TELEPHONES

1317.40
1313.68
2631.08
1315.02

2638.25
2637.85
1318.93

1319.25
1318.18
2637.43
1318.74
3744

2637.85

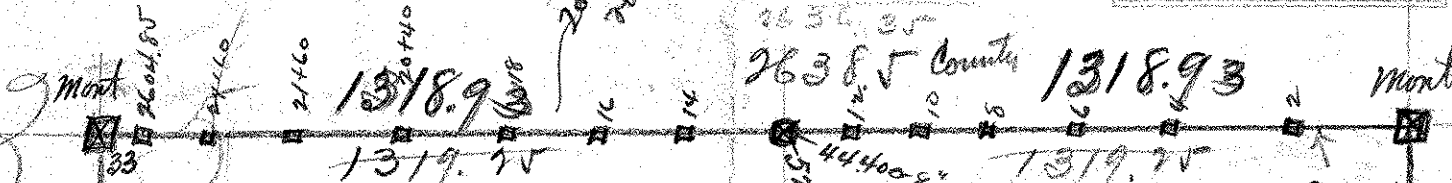

Angle. 2

NE 1/4 SE 1/4

2634.79
57.62
2631.07

1317.40

10-4.07
in 1399'
1318.71
1318.44

Mr. Brown
4.5'
1318.44
1318.71
1318.44

80.77
live need

1315.54

21.40
12" 100'
Random (see record above on plat)

1313.68

2627.36

1317.40

1317.95
1318.18

61.16

27.78
TP #720

1318.18

1317.95

2635.90
1317.95

183.45

32.35

27.78

2636.35
iron in S. wheel track
county

1313.68

1318.18
1317.95
52.20