


WEST 1/2, S.E. 1/4, & N.E. 1/4, S.E. 1/4.
SEC. 35 TOWN 30 RANGE 22.

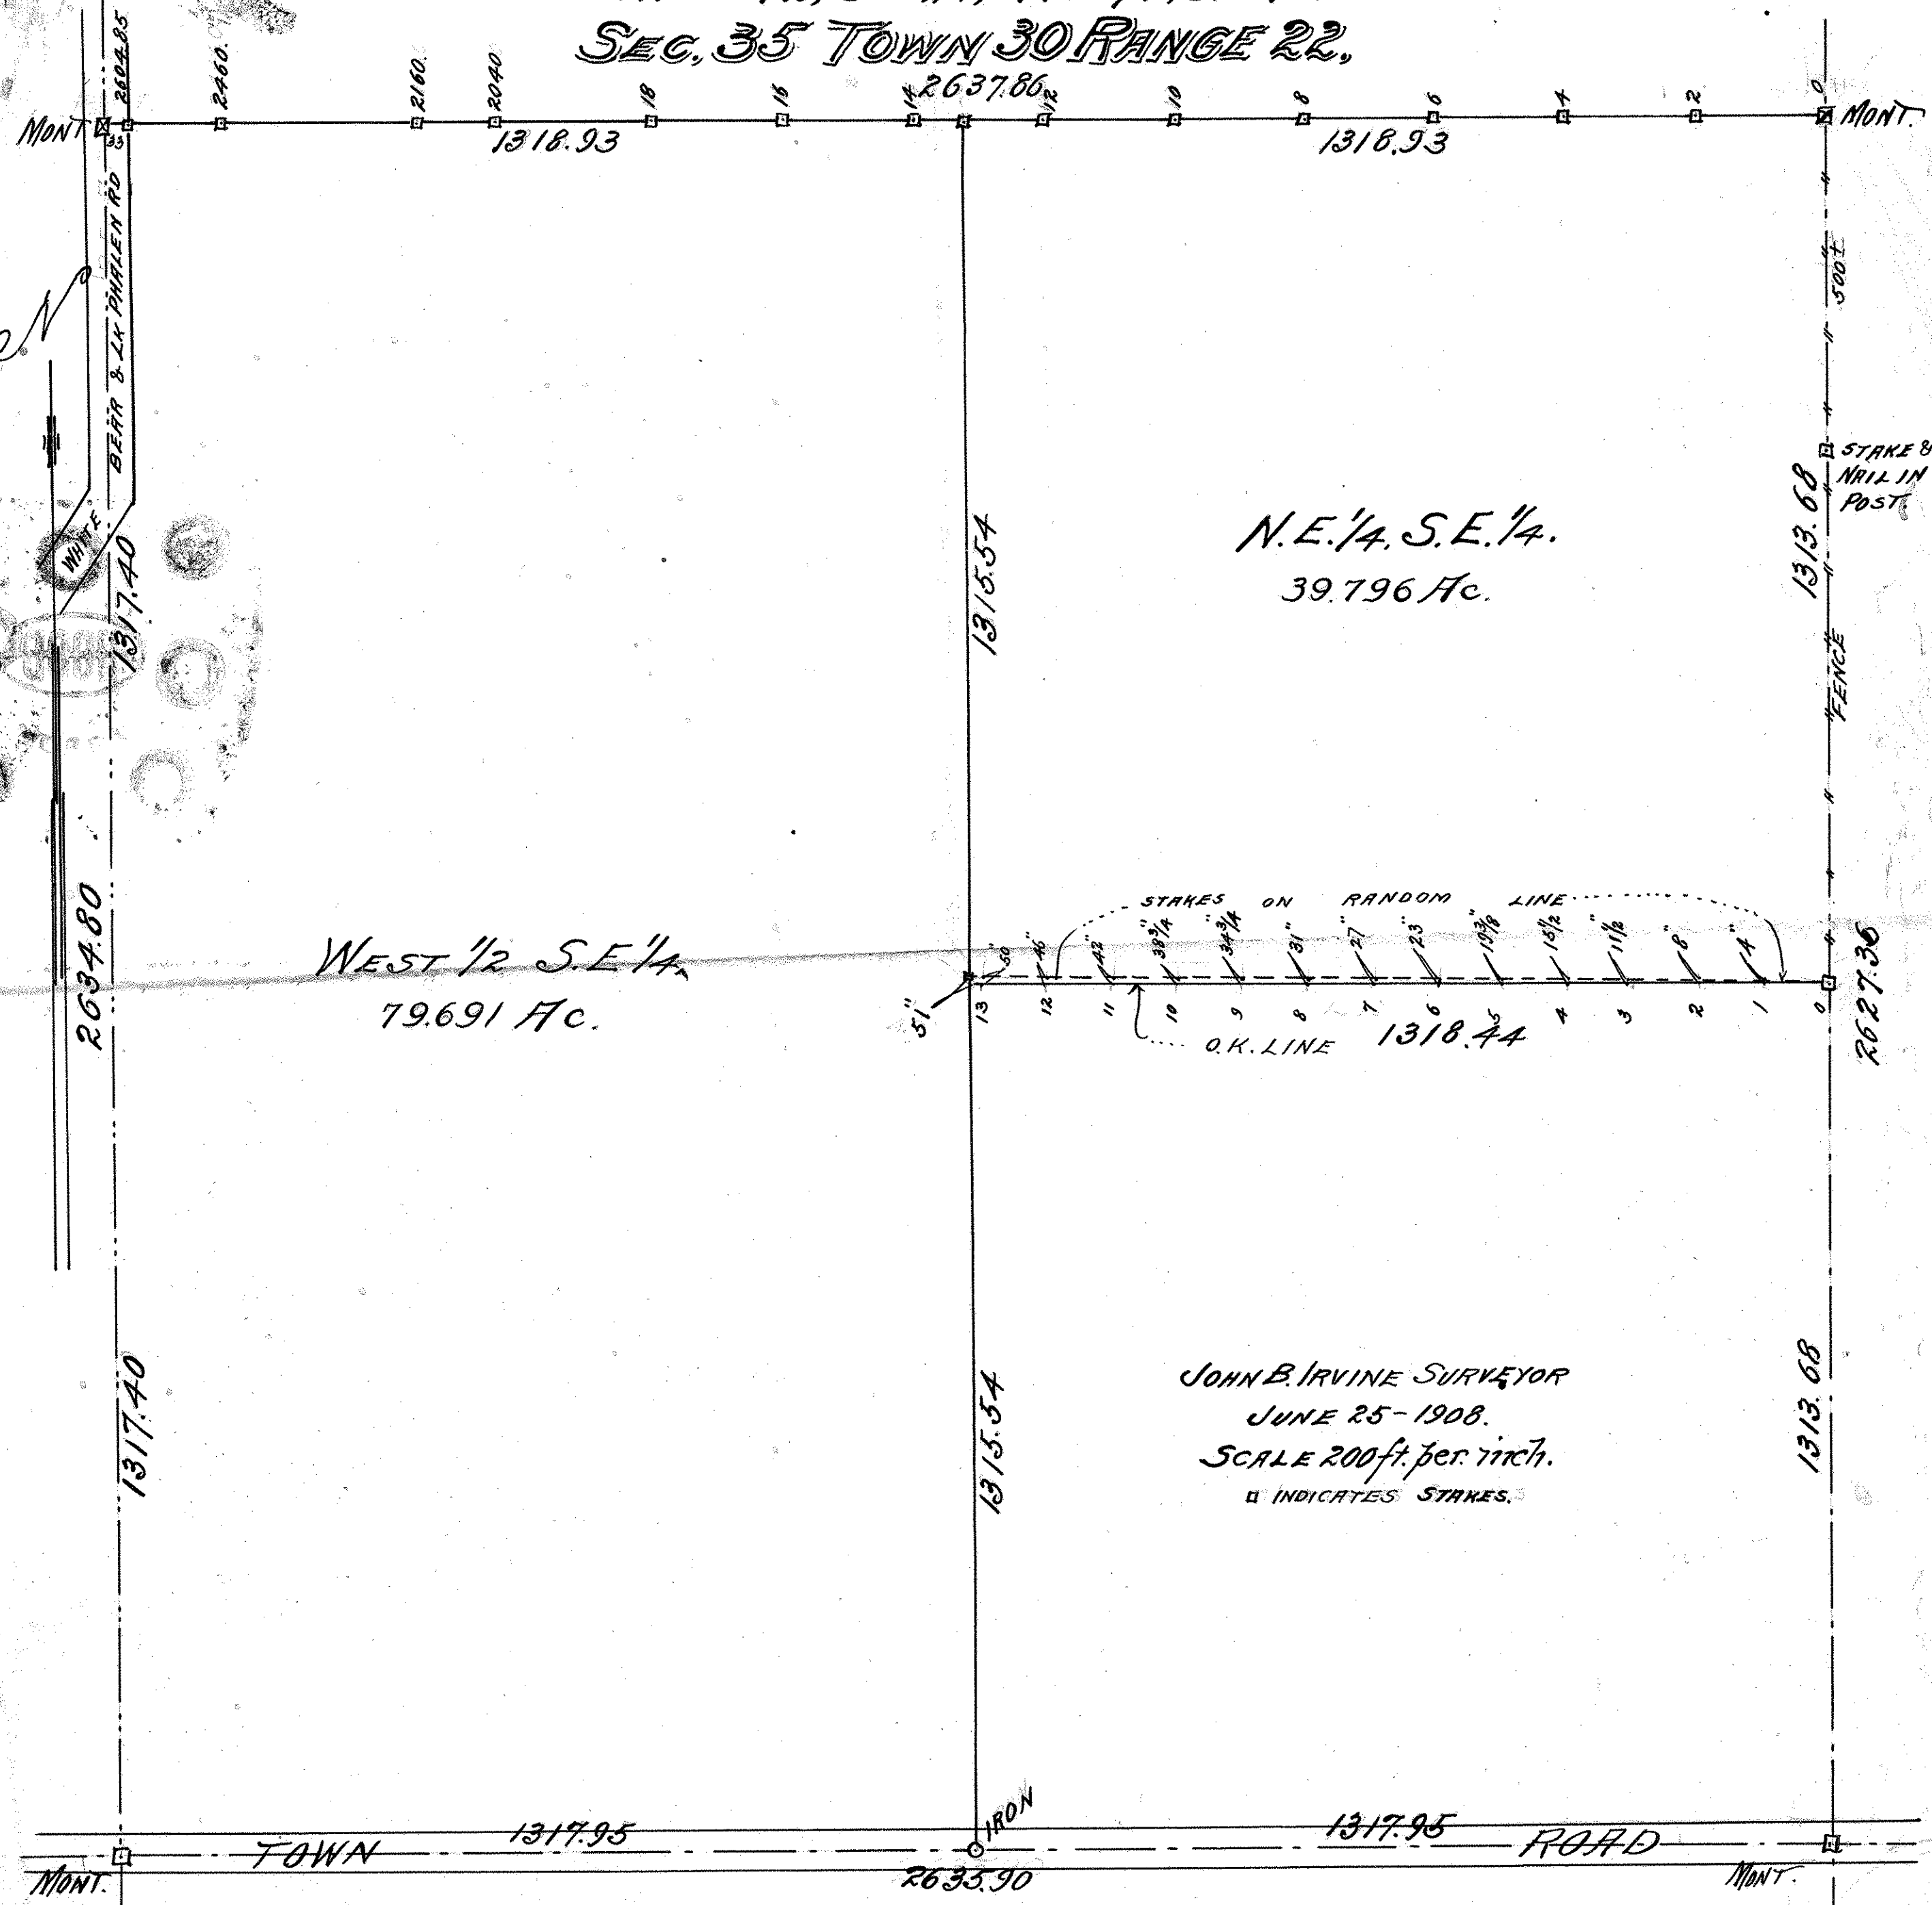

N.E. 1/4, S.E. 1/4.
39.796 Ac.

WEST 1/2 S.E. 1/4.
79.691 Ac.

JOHN B. IRVINE SURVEYOR
JUNE 25-1908.
SCALE 200 ft. per inch.
□ INDICATES STAKES.

BEARR & LA PHILEN RD
BEARRS
WHITE
1317.40
2634.80
MONT.

STAKE 8
NAIL IN
POST

STAKES ON RANDOM LINE
O.K. LINE 1318.44

FENCE

TOWN ROAD
1317.95

IRON