SE¼, SE¼, SEC-35, T-30-N, R-22
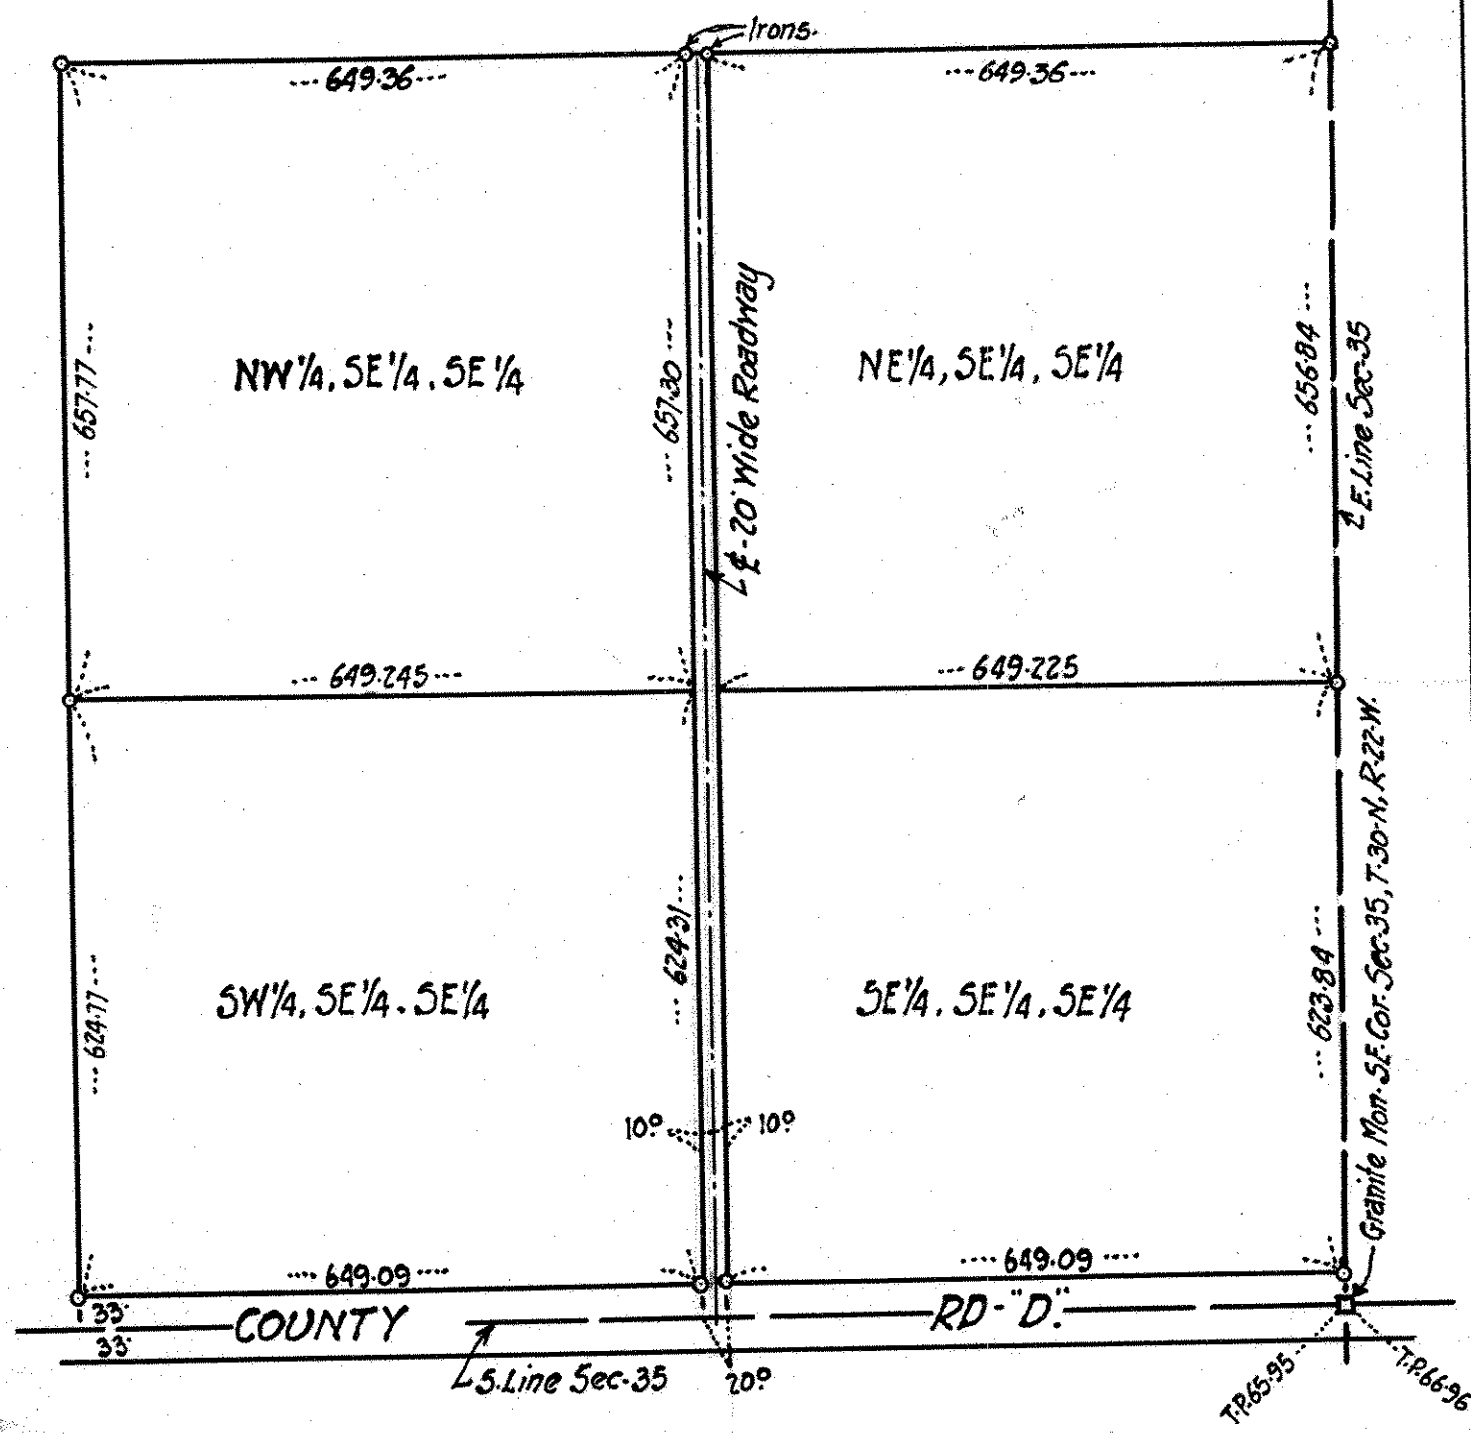
SURVEY OF 20 FT. ROADWAY FOR T
WHITE BEAR TOWNSHIP. JULY, 17. 1929
By P.R. Banister - Registered Professional Engr.
69-7th Ave - North St. Paul, Minn. Scale-1"=200'