

## CHARLES O. GEORGI COMPANY

2215 West County Road B

Saint Paul, Minnesota 55113

REGISTERED CIVIL ENGINEER AND LAND SURVEYOR

Certificate  
of Survey

Surveyed For Eagle Enterprises, Inc.

Date December 1973 - May 24, 1974


Scale 1" = 100'

I Hereby Certify that this plat shows a survey made by me of the property described on this plat, and that the corners are correctly placed as shown, and that all locations have been correctly shown.

5/24/74 Added Location of Building under construction.

By Charles O. Georgi

REGISTERED LAND SURVEYOR

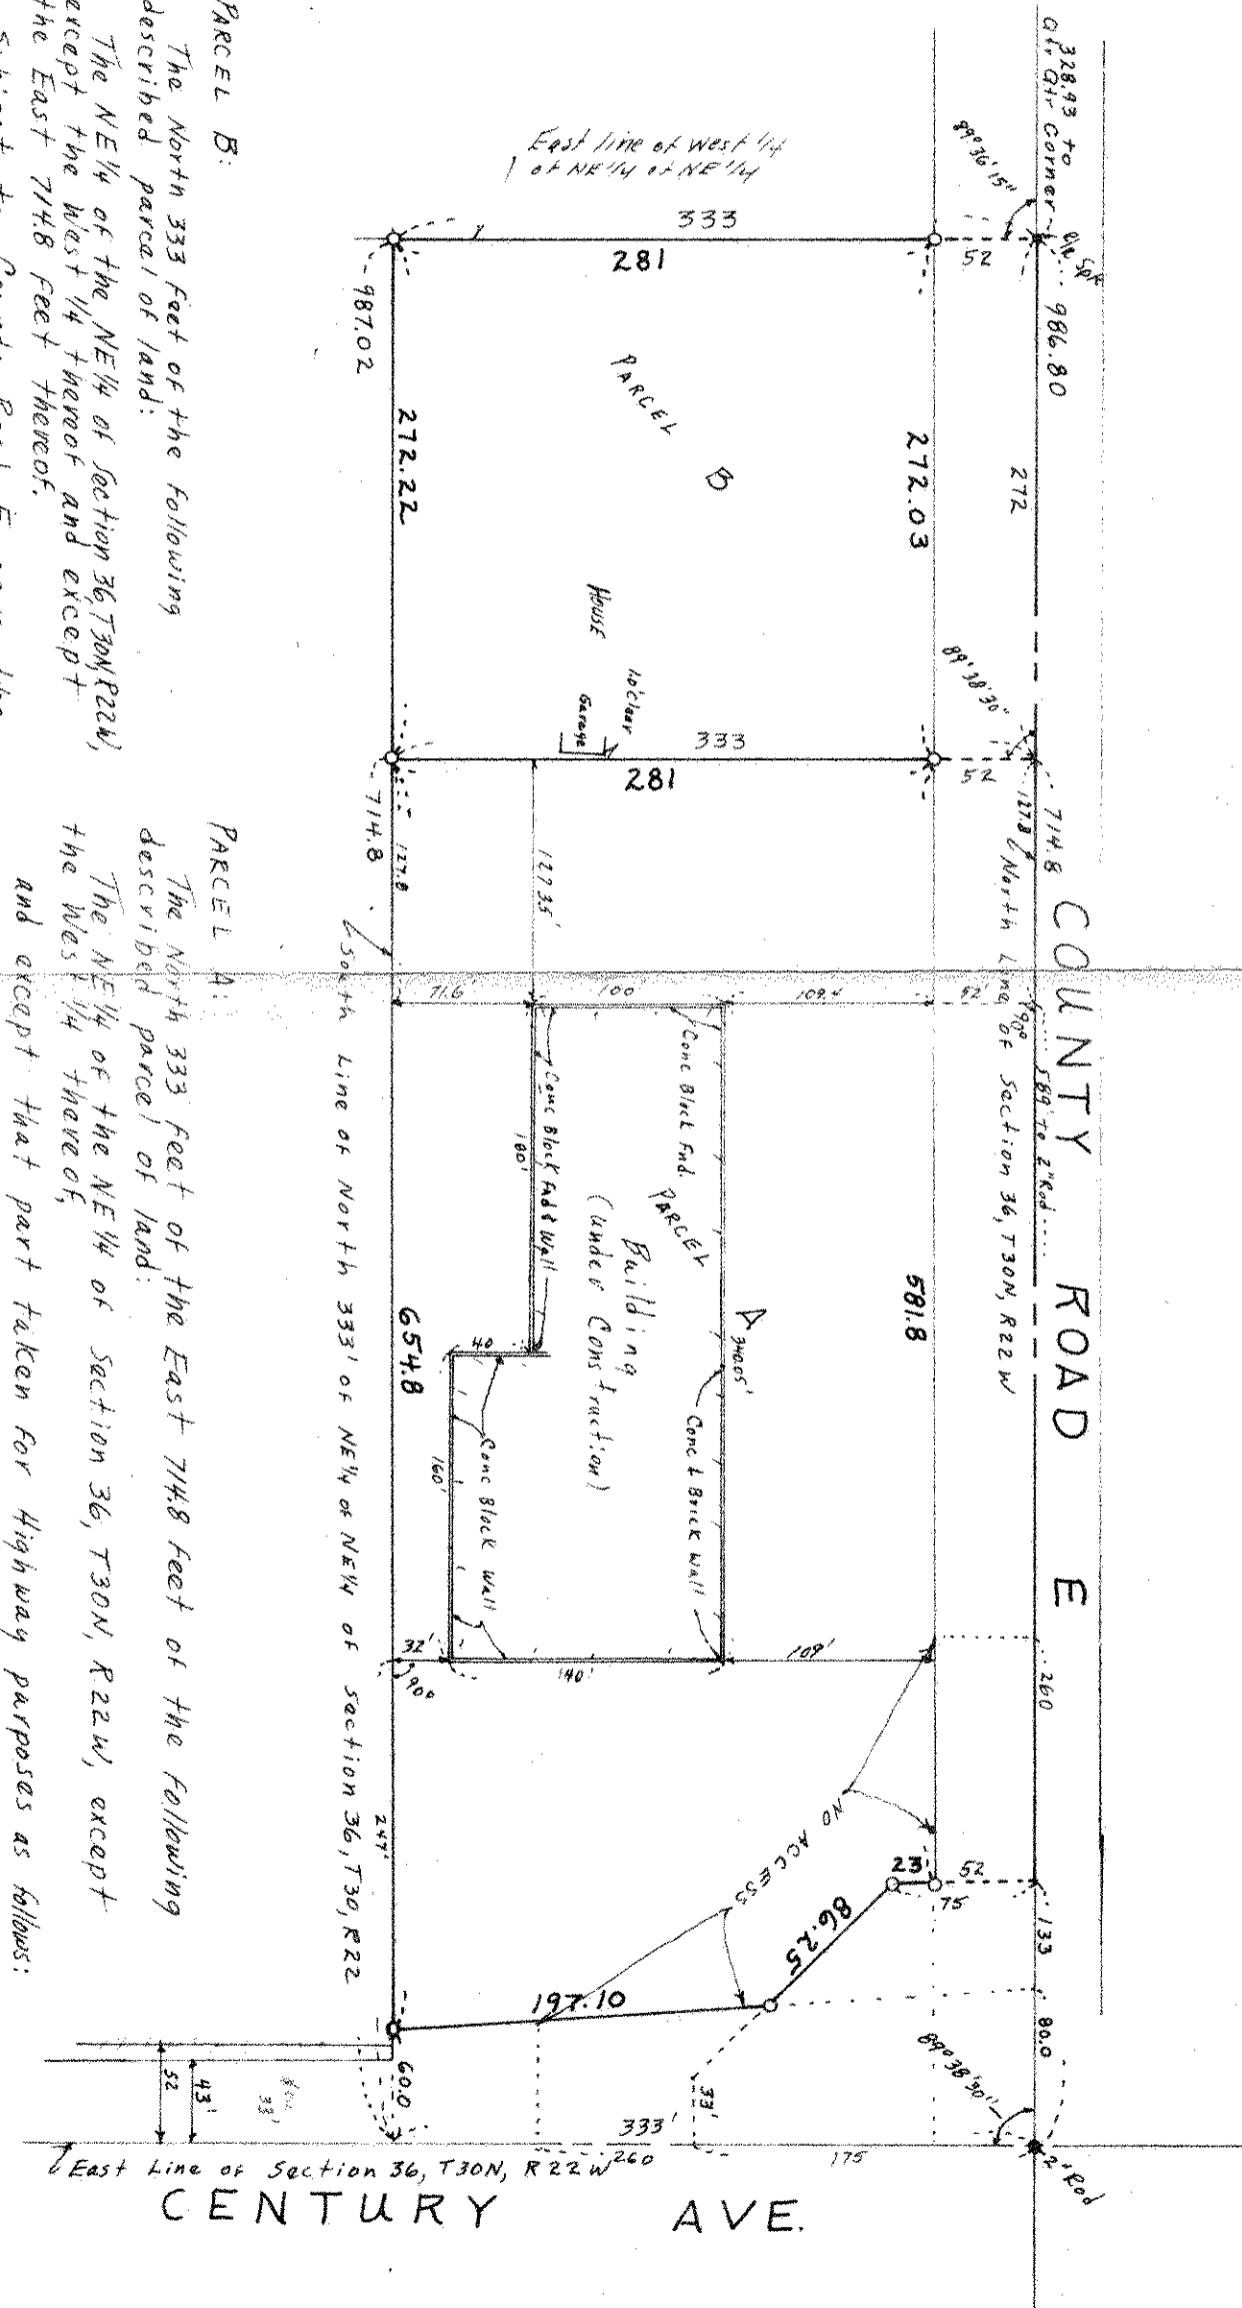

Ramsey County, Minnesota

**PARCEL B:**  
The North 333 feet of the following described parcel of land:  
The NE $\frac{1}{4}$  of the NE $\frac{1}{4}$  of Section 36, T30N, R22W, except the West  $\frac{1}{4}$  thereof, the East 714.8 feet thereof, Subject to County Road E over the

**PARCEL A:**  
The North 333 feet of the East 714.8 feet of the following described parcel of land:  
The NE $\frac{1}{4}$  of the NE $\frac{1}{4}$  of Section 36, T30N, R22W, except the West  $\frac{1}{4}$  thereof,

and except that part taken for Highway purposes as follows:

The Northeast  $\frac{1}{4}$  of the NE $\frac{1}{4}$  of the NE $\frac{1}{4}$  of said Section 36 which lies Northerly of a line run parallel with and distant 75 feet Southwesterly of the North line of said Section 36; together with a triangular piece adjoining and Southerly of the above described strip and Northeast  $\frac{1}{4}$  of the following described line: beginning at a point distant 33 feet West and 75 feet South of the Northeast corner of said Section 36, thence Southeasterly to a point 33 feet West and 175 feet South of the Northeast corner of said Section 36;

and excepting the North 52 feet of said NE $\frac{1}{4}$  of NE $\frac{1}{4}$  for County Road E;

and excepting that part taken for Highway purposes which lies Easterly of the following described line: Beginning at a point on the North line of said Section 36 Distant 60 feet West of the Northeast corner thereof, thence run Southeastward to a point on the South line of the North 333 feet distant 60 feet West of the East line of said Section 36 and there terminating.

Ramsey County, Minnesota