

FROM THE OFFICE OF

CHARLES O. GEORGI COMPANY

2215 West County Road B

Saint Paul, Minnesota 55113

REGISTERED CIVIL ENGINEER AND LAND SURVEYOR

**Certificate
of Survey**

I Hereby Certify that this plat shows a survey made by me of the property described on this plat, and that the corners are correctly placed as shown, and that all locations have been correctly shown.

Surveyed For *George Frandsen*

Date *August 1975*


Scale *1" = 40'*

By *Charles O. Georgi*
REGISTERED LAND SURVEYOR

Description:

*Lots 5, Block 11,
Bel-Air Park No. 2,
Ramsey County,
Minnesota*

MAYFAIR AVE.

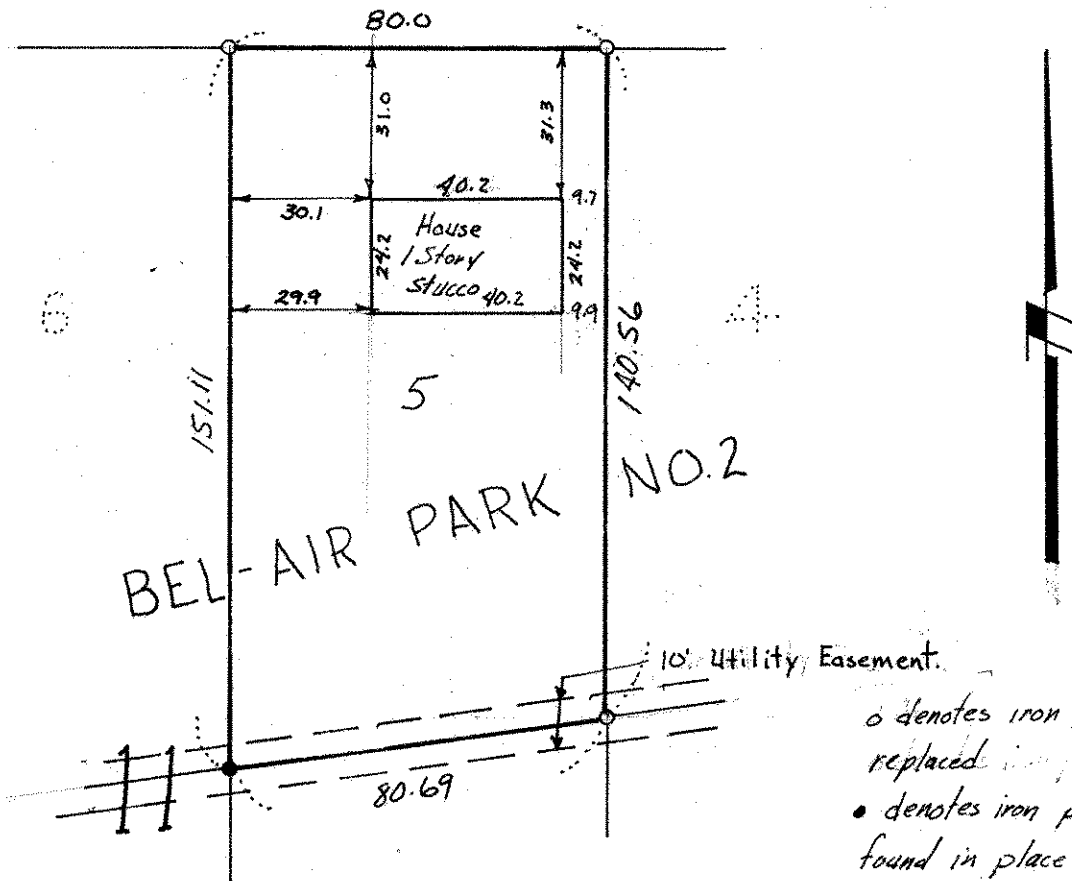

o denotes iron pipe monument
replaced in pipe socket.
• denotes iron pipe monument
found in place