

FROM THE OFFICE OF

CHARLES O. GEORGI COMPANY

2215 West County Road B

Saint Paul, Minnesota 55113

REGISTERED CIVIL ENGINEER AND LAND SURVEYOR

**Certificate
of Survey**

I Hereby Certify that this plat shows a survey made by me of the property described on this plat, and that the corners are correctly placed as shown, and that all locations have been correctly shown.

Surveyed For *James J. McSherry*


Date *March 1972*

Drawn *3/25/72*
Scale *1" = 30'*

By *Charles O. Georgi*
REGISTERED LAND SURVEYOR

Description: - "Deed No 1"

*Lot 6 and 7, Block 5,
Syndicate Addition to Minneapolis Stackyards
Ramsey County, Minn*

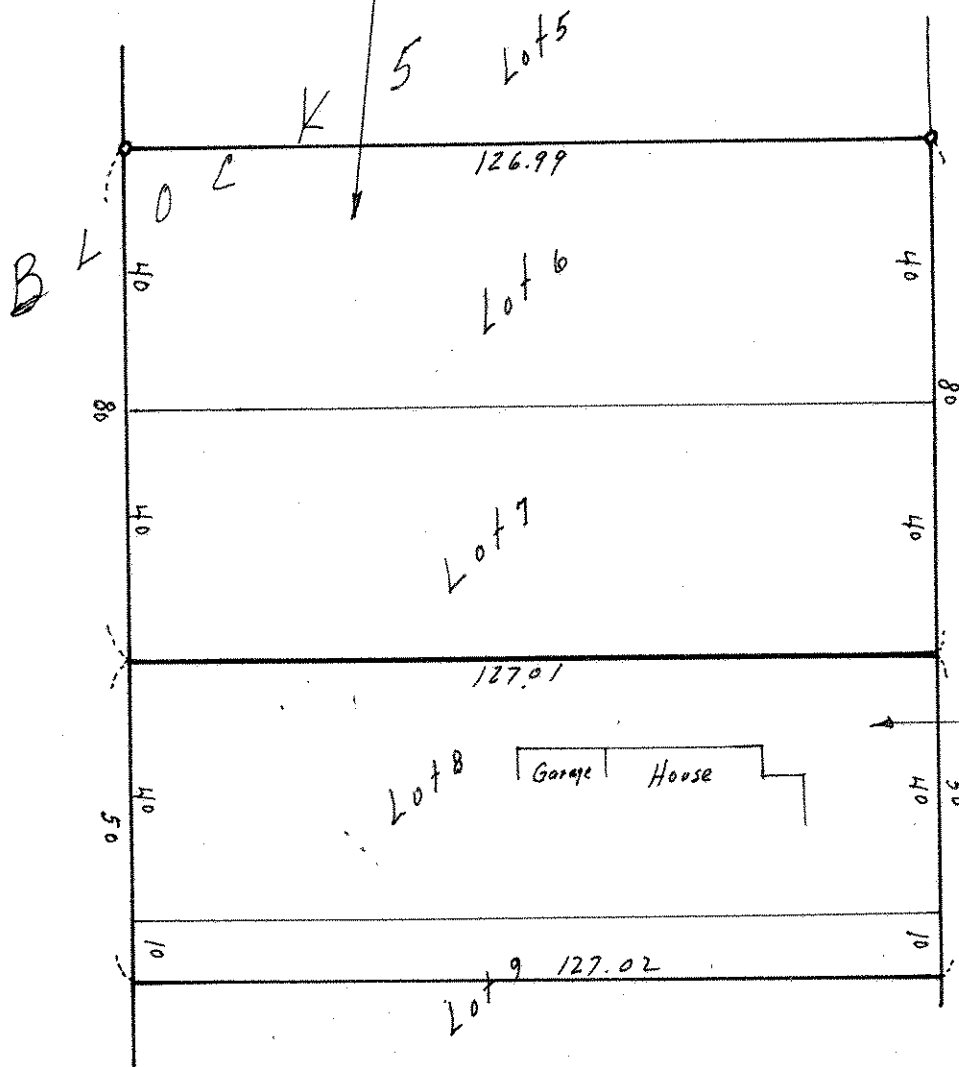

Description: "Deed No 2"
*Lot 8 and the North 10 feet
of Lot 9, Block 5, Syndicate
Addition to Minneapolis
Stackyards, Ramsey County,
Minn.*

o Denotes Iron Pipe Monument.