SW 22 30 23

FROM THE OFFICE OF

# CHARLES O. GEORGI COMPANY

2215 West County Road B Saint Paul, Minnesota 55113

REGISTERED CIVIL ENGINEER AND LAND SURVEYOR

# Certificate of Survey

***I Hereby Certify that*** **this plat shows a survey made by me of the property described on this plat, and that the corners are correctly placed as shown, and that all locations have been correctly shown.**

***Surveyed For*** James Mc Clurg

***Date*** April 1973

***Scale*** 1" = 30'

By Charles O. Georgi
REGISTERED LAND SURVEYOR

***Description:***

Lot 1, Block 1, Valentine Lake View
Ramsey County, Minnesota
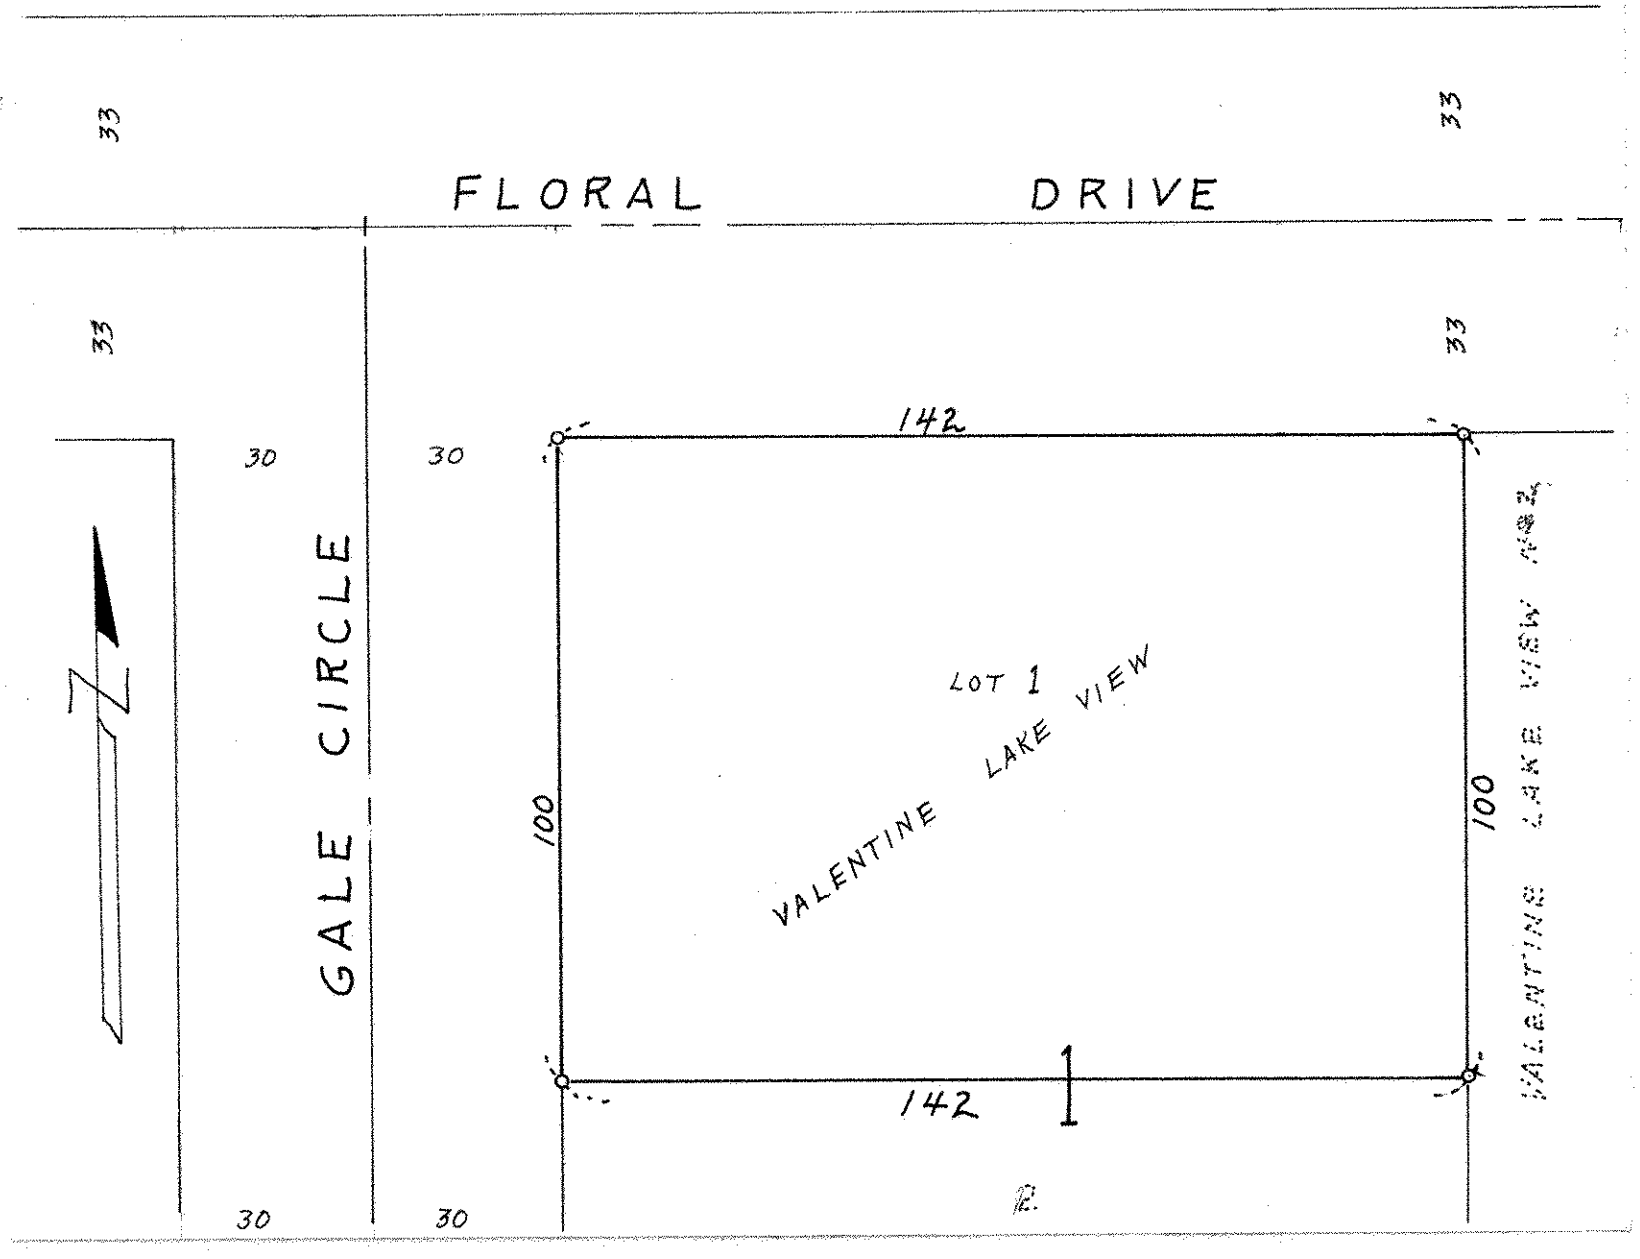
o Denotes Iron Monument