NW 36 30 23

Certificate of Survey

From the office of

GEORGI- SCHMIDT & ASSOC. INC.

3092 No. Lexington Ave., Roseville, Mn. 55113
LAND SURVEYING
483-4408

I Hereby Certify that this plat shows a survey made by me of the property described on this plat, and that the corners are correctly placed as shown, and that all locations have been correctly shown.

1/31/79 Added Proposed House

⊗ Denotes Nub & Nail set
x Denotes lathe set

Job Number: 232

Surveyed For Greg Sowieja

Date 1/17/79

Scale 1"=40'

By Donald W. Schmidt
REGISTERED LAND SURVEYOR

Description:
Lot 22, Block 1, Lakeshore Oaks Addition No. 2
Ramsey County, Mn.

REVISED SEE BUJALSKI OCT 79

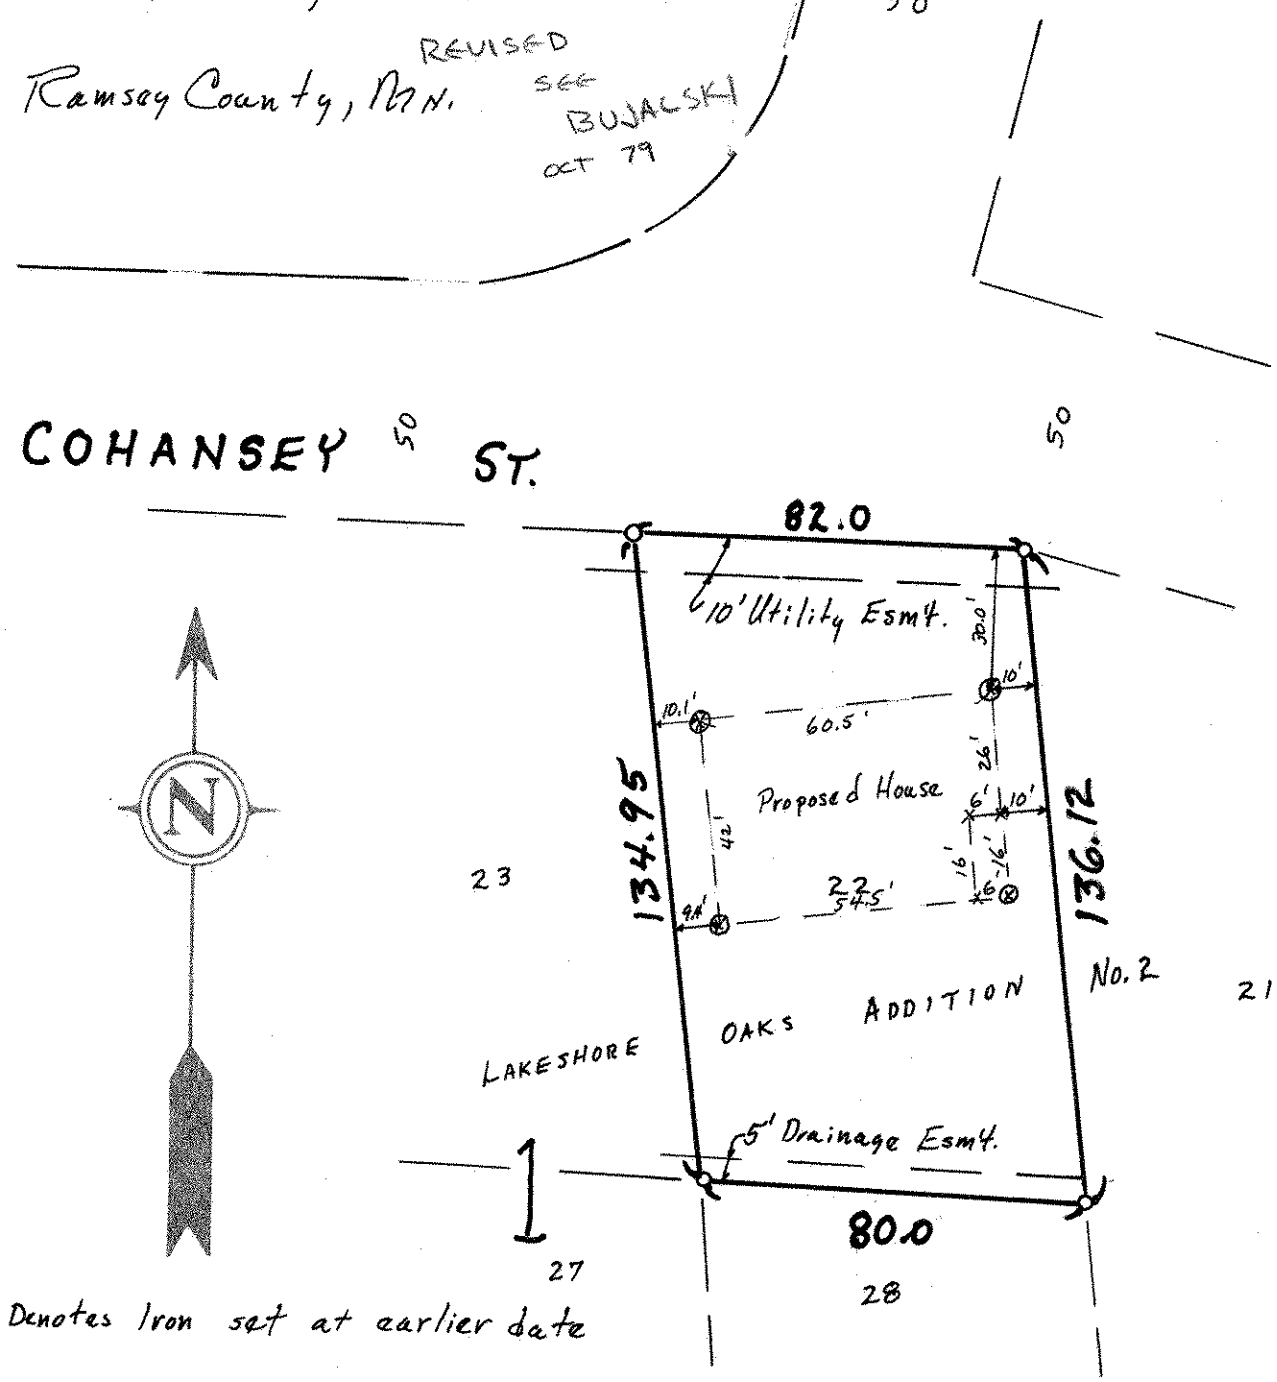

O Denotes Iron set at earlier date