NW 6 30 23

Certificate of Survey

From the office of

GEORGI- SCHMIDT & ASSOC. INC.

3092 No. Lexington Ave., Roseville, Mn. 55113

LAND SURVEYING

483-4408

I Hereby Certify that this plat shows a survey made by me of the property described on this plat, and that the corners are correctly placed as shown. That this survey was done by me, or under my direct supervision; and that I am a duly registered Land Surveyor under the Laws of the State of Minnesota.

Job Number: 3042

Surveyed For Robert Witt

Date 5/9/86

Scale 1" = 40'

By _____

REGISTERED LAND SURVEYOR

Mn. Reg. #10459

DESCRIPTION:

The South 74.0 feet of the East 350.0 feet of Lot 16, Auditor's Subdivision No. 89.
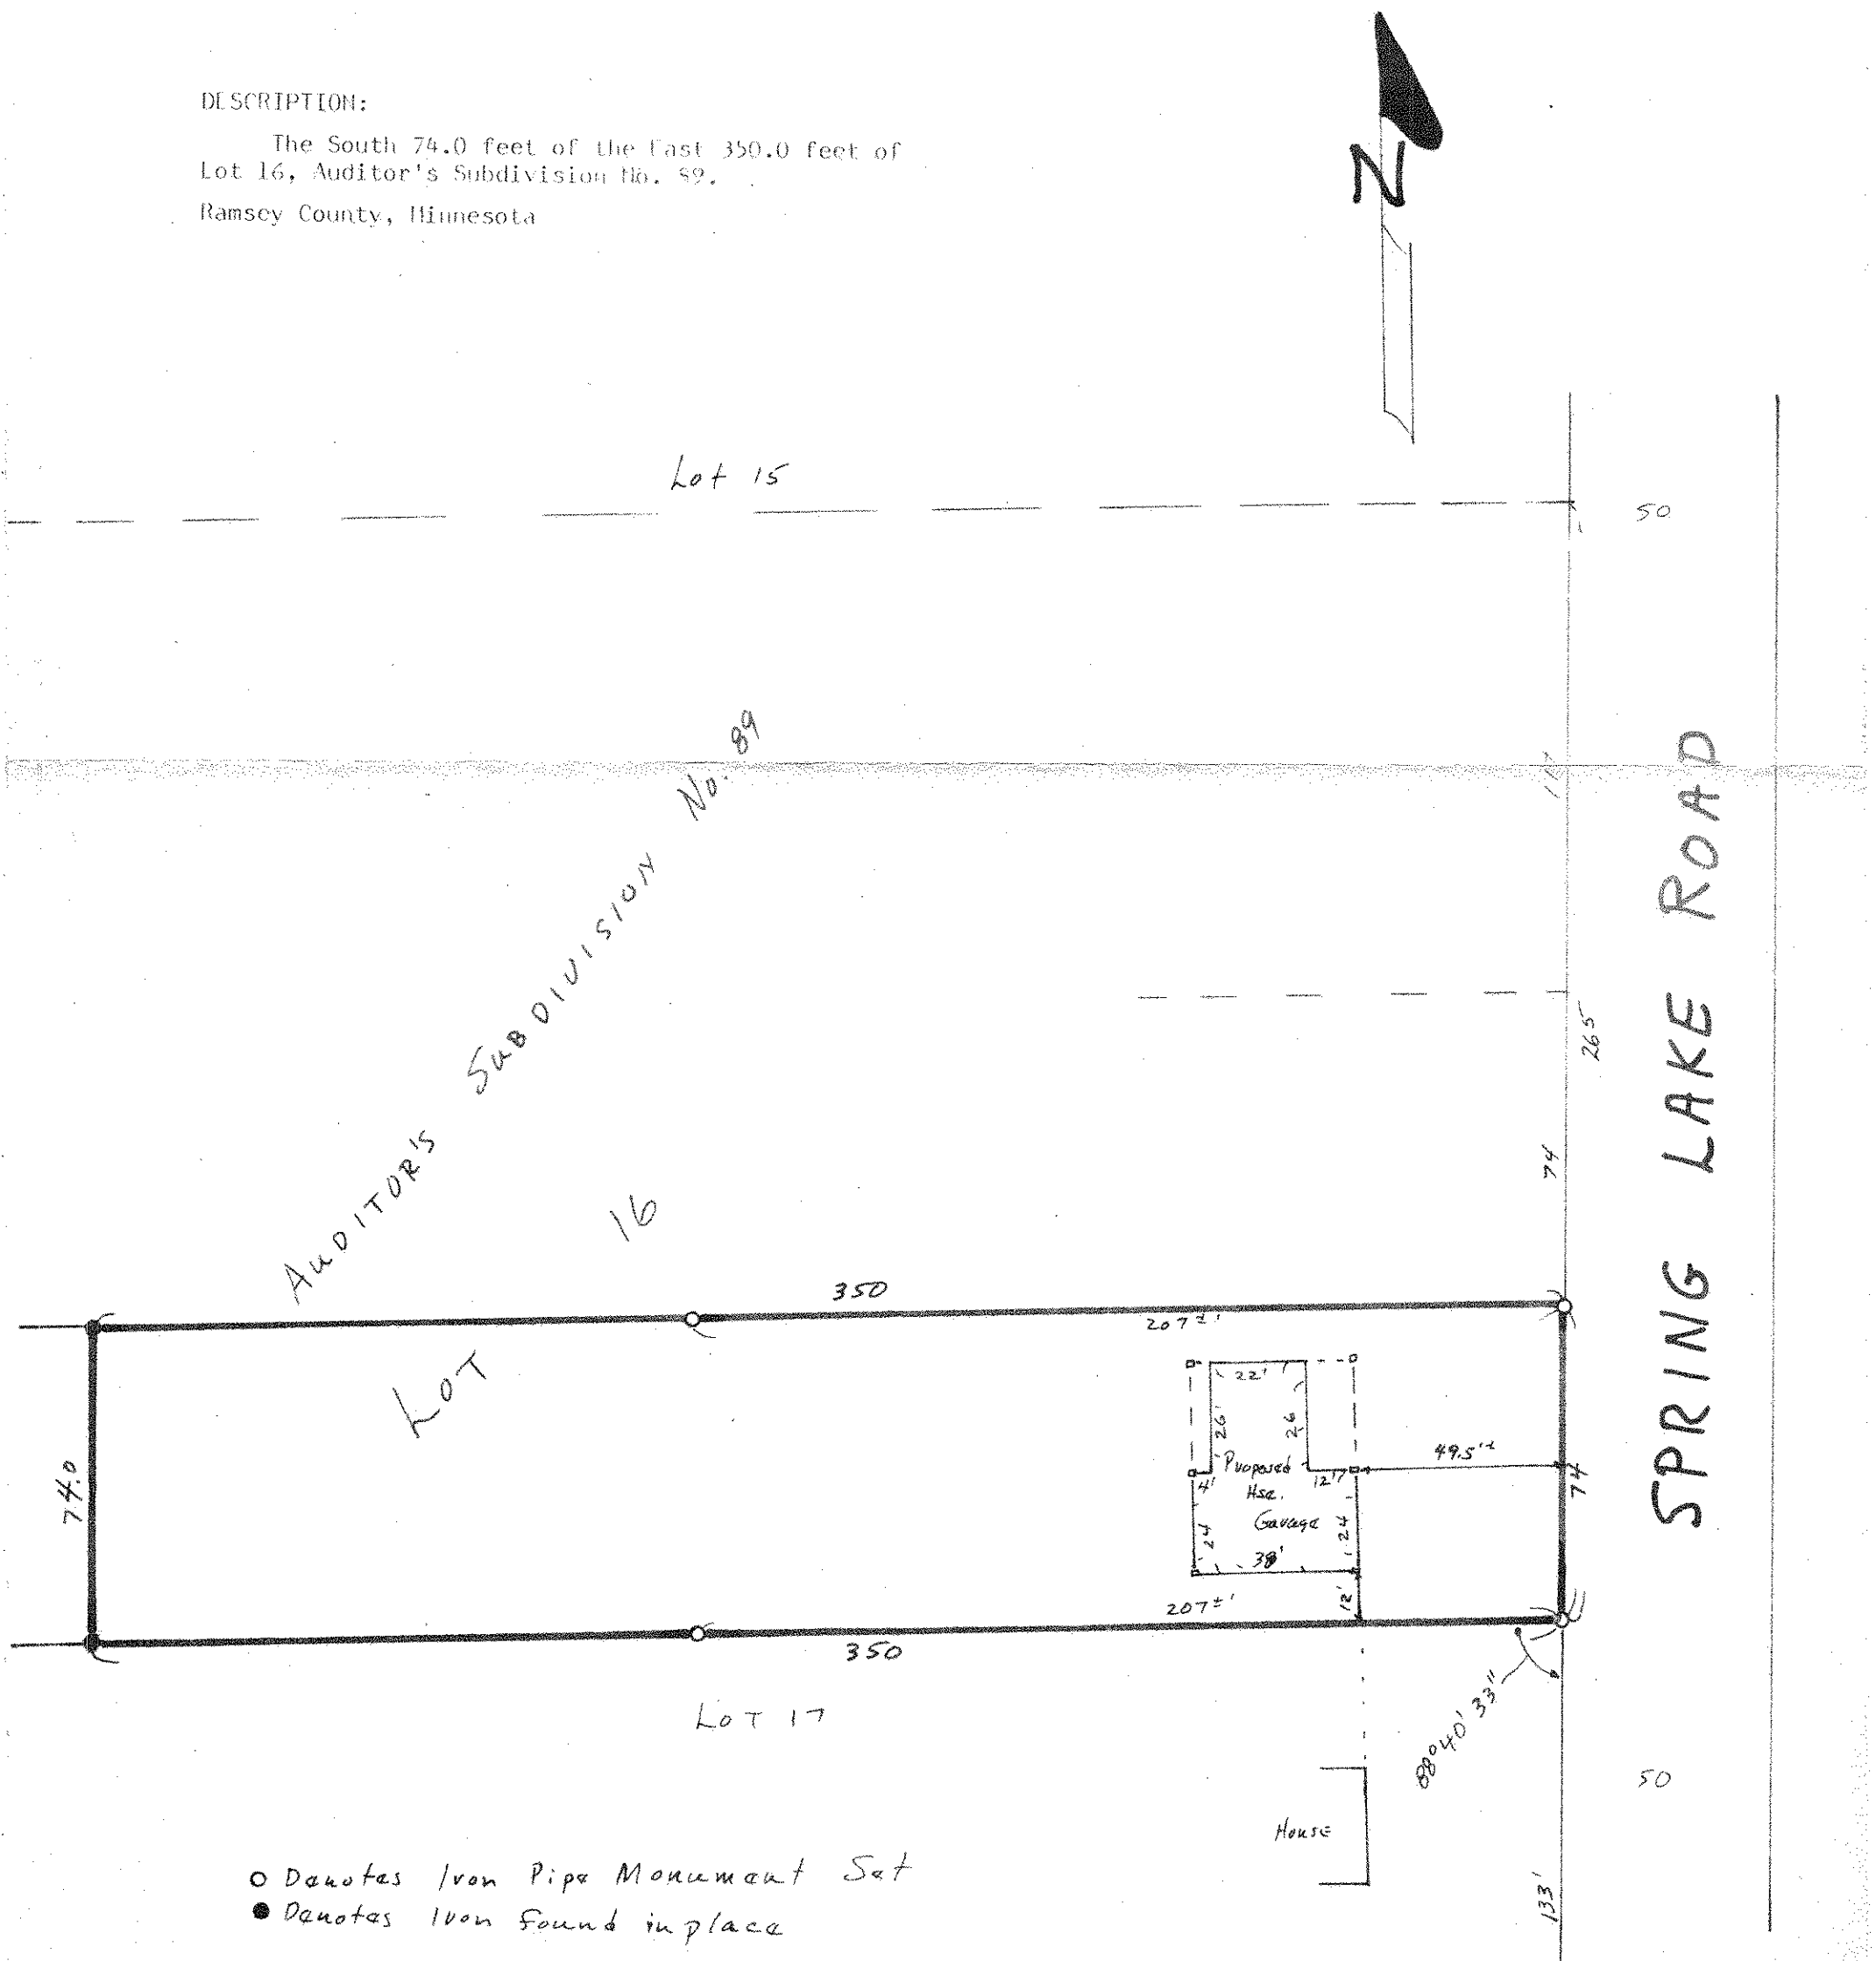
Ramsey County, Minnesota