


~ PLAT OF SURVEY ~

Lot 3, Block 3, BAKEN ADDITION PLAT No 2  
No 4374 Reiland Lane, Shoreview, Minn.

SCALE: 1" = 30'

T. J. Welch  
Registered Surveyor  
701 East 3rd St.  
ST. PAUL, MINN. 55106  
TEL. 776-0640  
Oct. 2, 1967

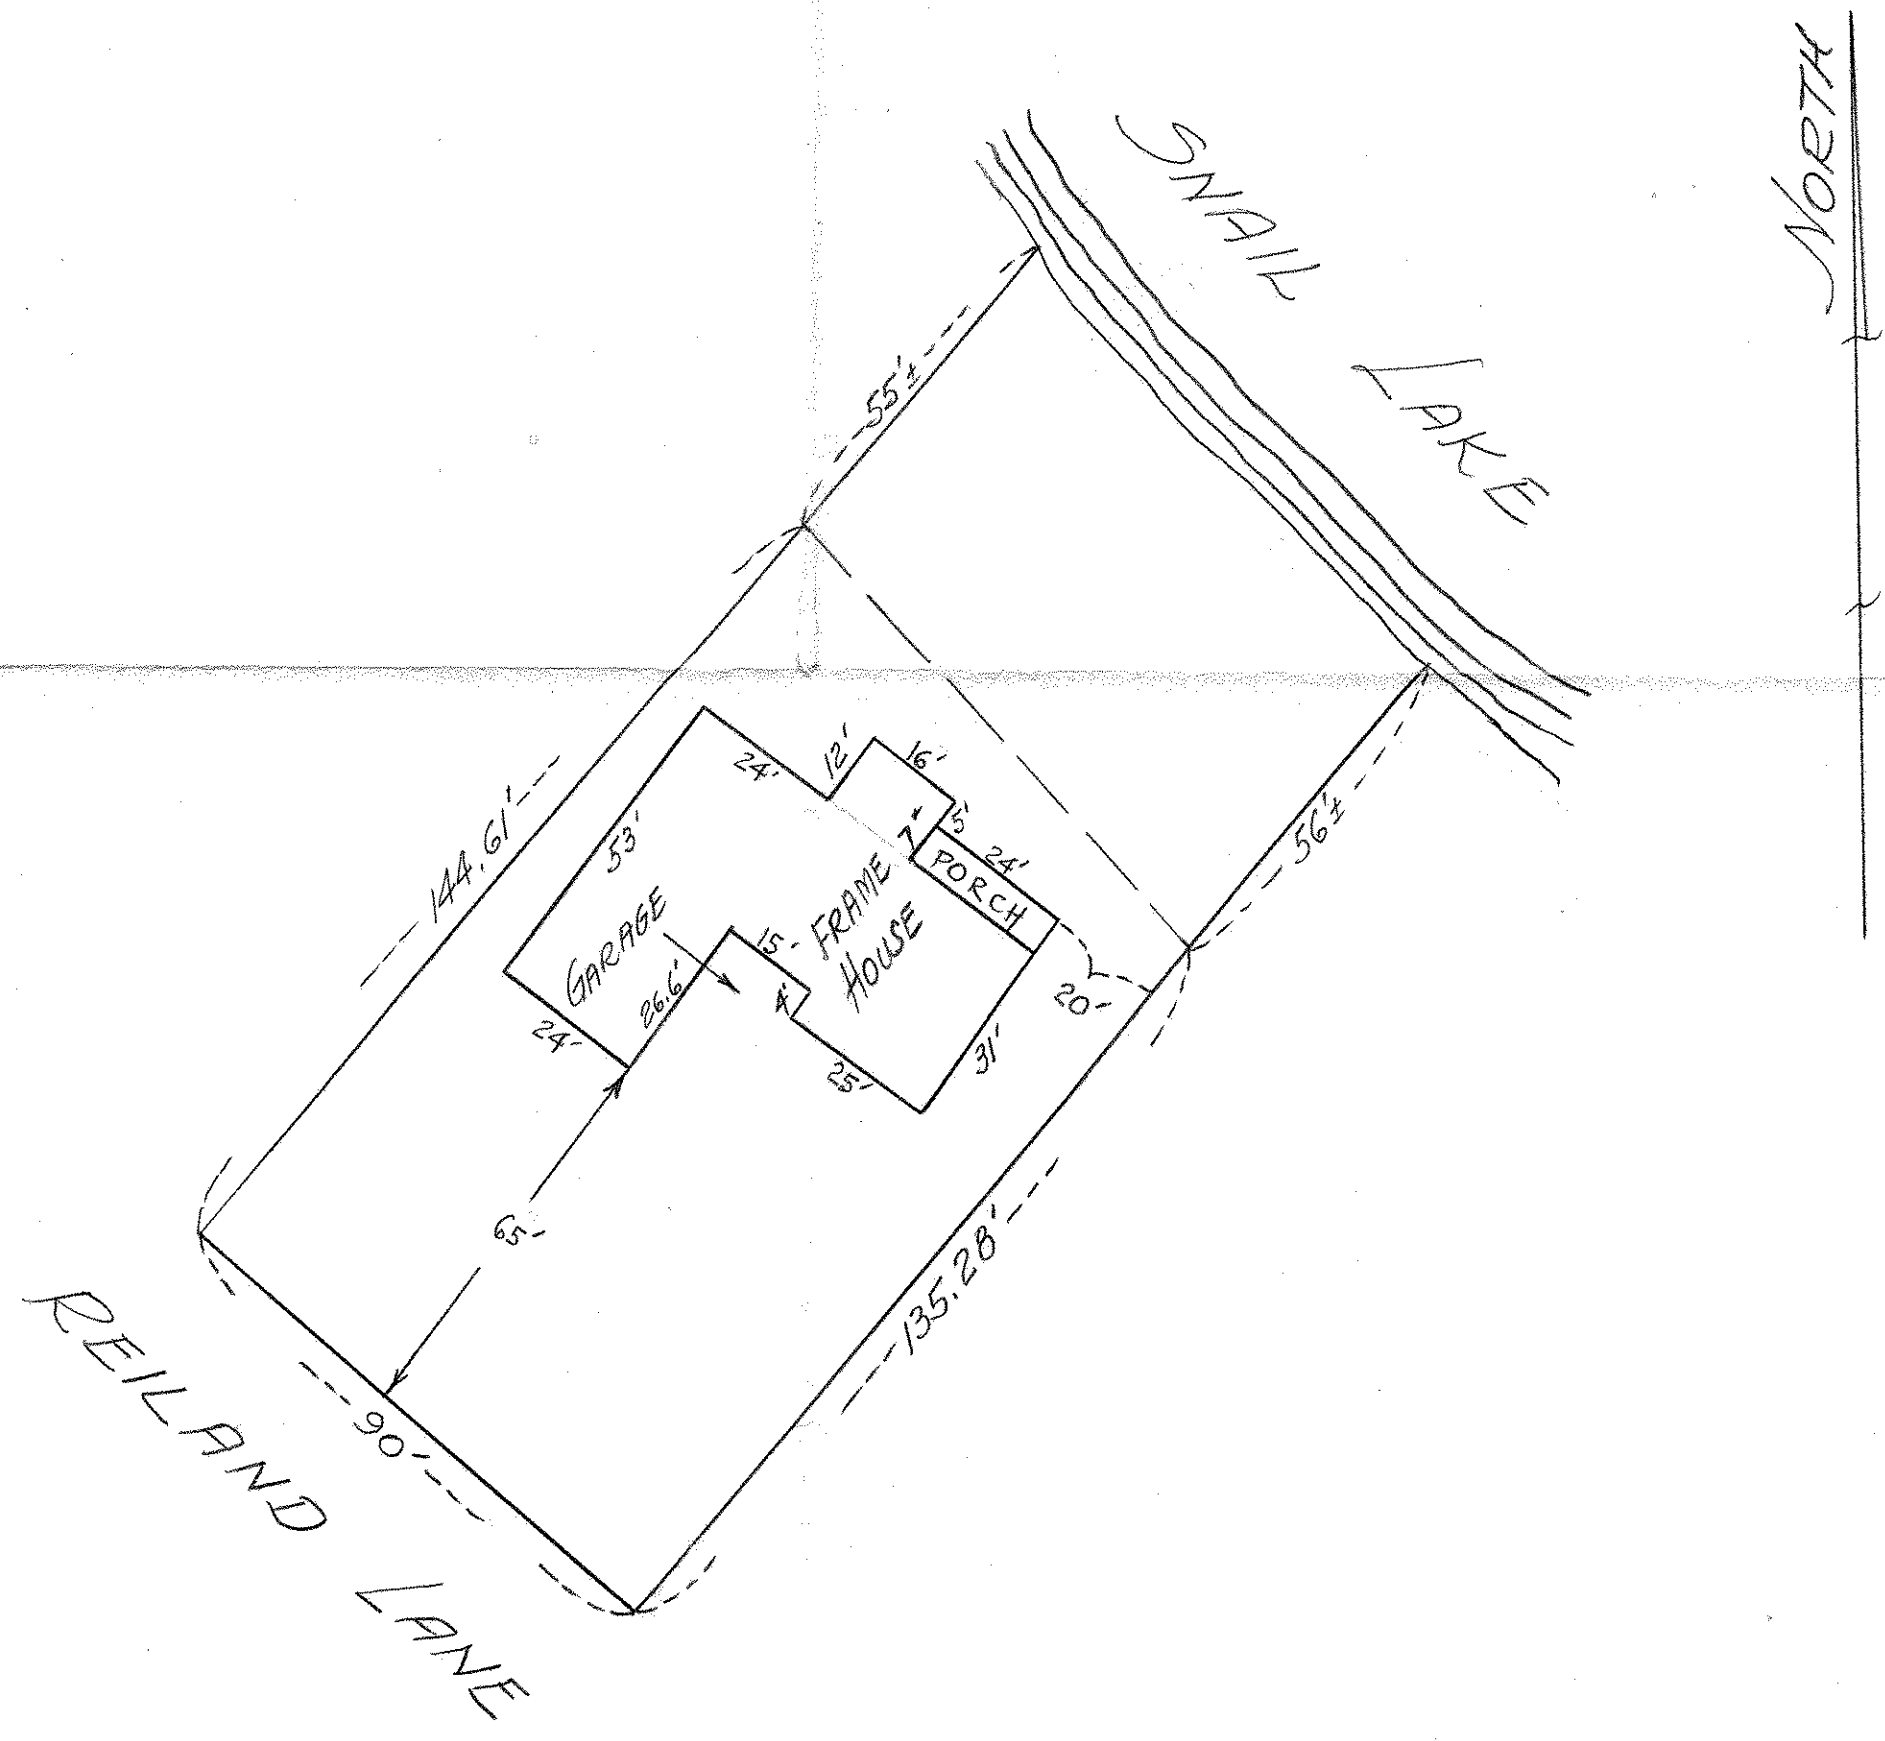

Mortgage Loan Survey only.