


# COMSTOCK AND DAVIS INC.

3092 N. LEXINGTON AVE. ST. PAUL, MN. 55113 483-4408

SURVEYED FOR: Brian and Gail Nelson

DESCRIPTION: Lot 32, Block 5, Hills Of Oaks. Ramsey County, Minnesota

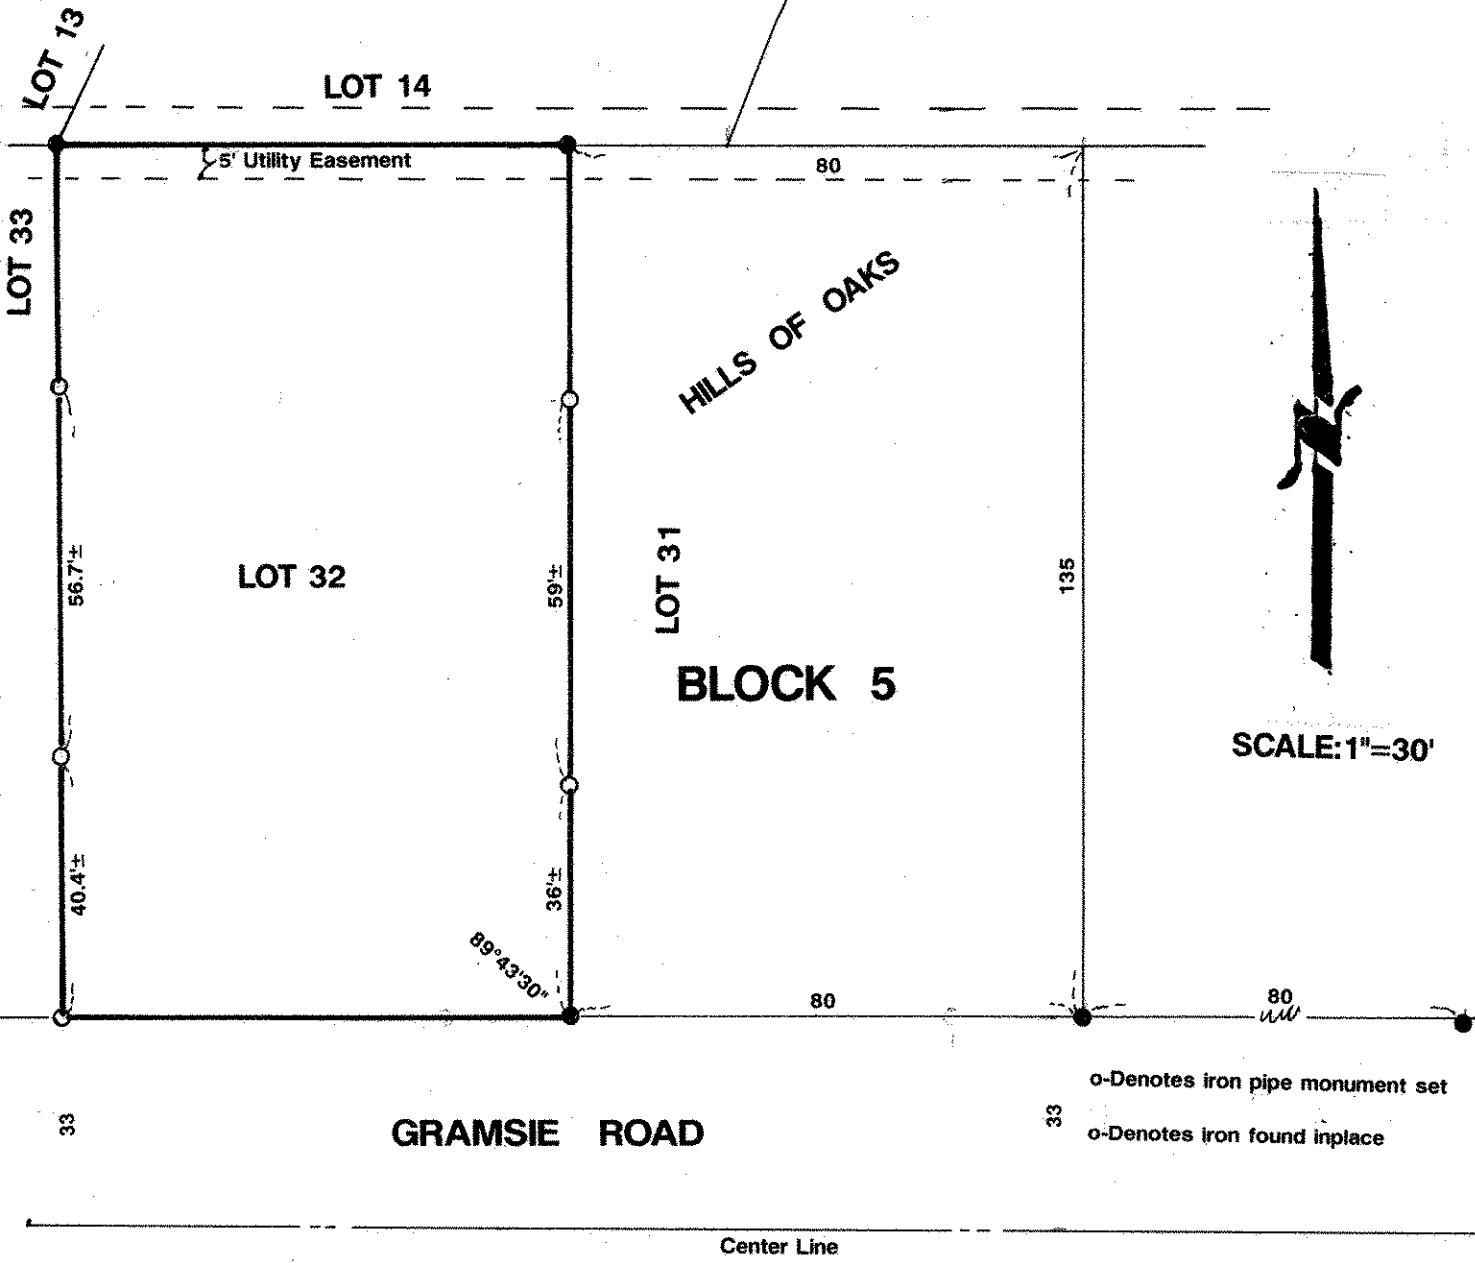

I hereby certify that this survey, plan plat, preliminary plat or report was prepared by me or under my direct supervision and that I am a duly Registered Land Surveyor under the laws of the State of Minnesota.

*Donald A. Schaud*

10459  
Reg. No.

8/17/93  
Date

931354  
Job No.

Book No.