

**Certificate
of Survey**

From the office of
GEORGI-SCHMIDT & ASSOC. INC.
3092 No. Lexington Ave., Roseville, Mn. 55113
LAND SURVEYING
483-4408

I Hereby Certify that this plat shows a survey made by me of the property described on this plat, and that the corners are correctly placed as shown, and that all locations have been correctly shown.

Job Number: 1048

Surveyed For Dale Eichelberg


Date Sept, 19, 1981

Scale 1" = 40'

By Orwell W. Schmidt
REGISTERED LAND SURVEYOR

Description:

Lot 1, Block 3,
Lake Johanna Park,
Ramsey County, Minnesota

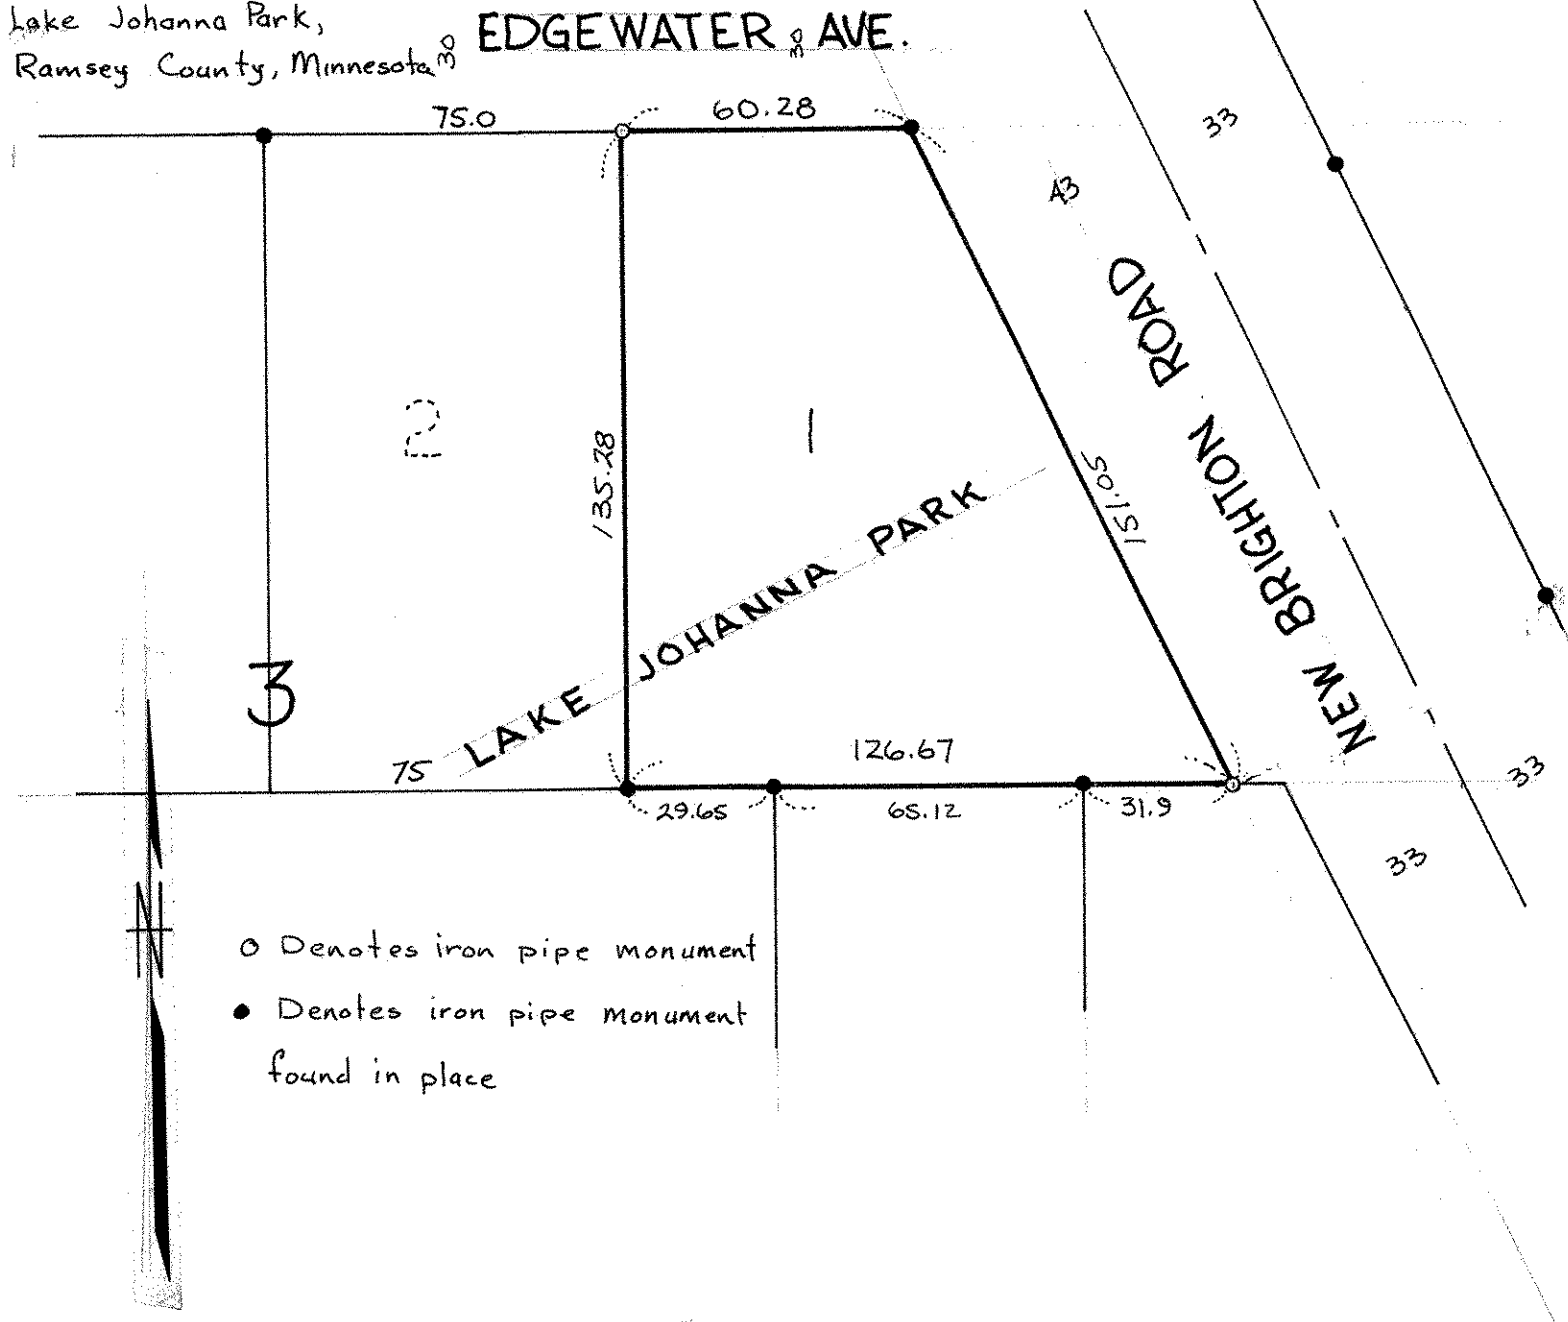

○ Denotes iron pipe monument
● Denotes iron pipe monument found in place