SW 32 30 23

Certificate of Survey

From the office of

GEORGI- SCHMIDT & ASSOC. INC.

3092 No. Lexington Ave., Roseville, Mn. 55113

LAND SURVEYING

483-4408

I Hereby Certify that this plat shows a survey made by me of the property described on this plat, and that the corners are correctly placed as shown, and that all locations have been correctly shown.

Job Number: 654

Surveyed For Val Parranto - Attorney

Date 6/10/80

Scale 1" = 30'

By Donald W. Schmidt
REGISTERED LAND SURVEYOR

Description:
Lot 4, Block 12, Apache Hills Second Addition.
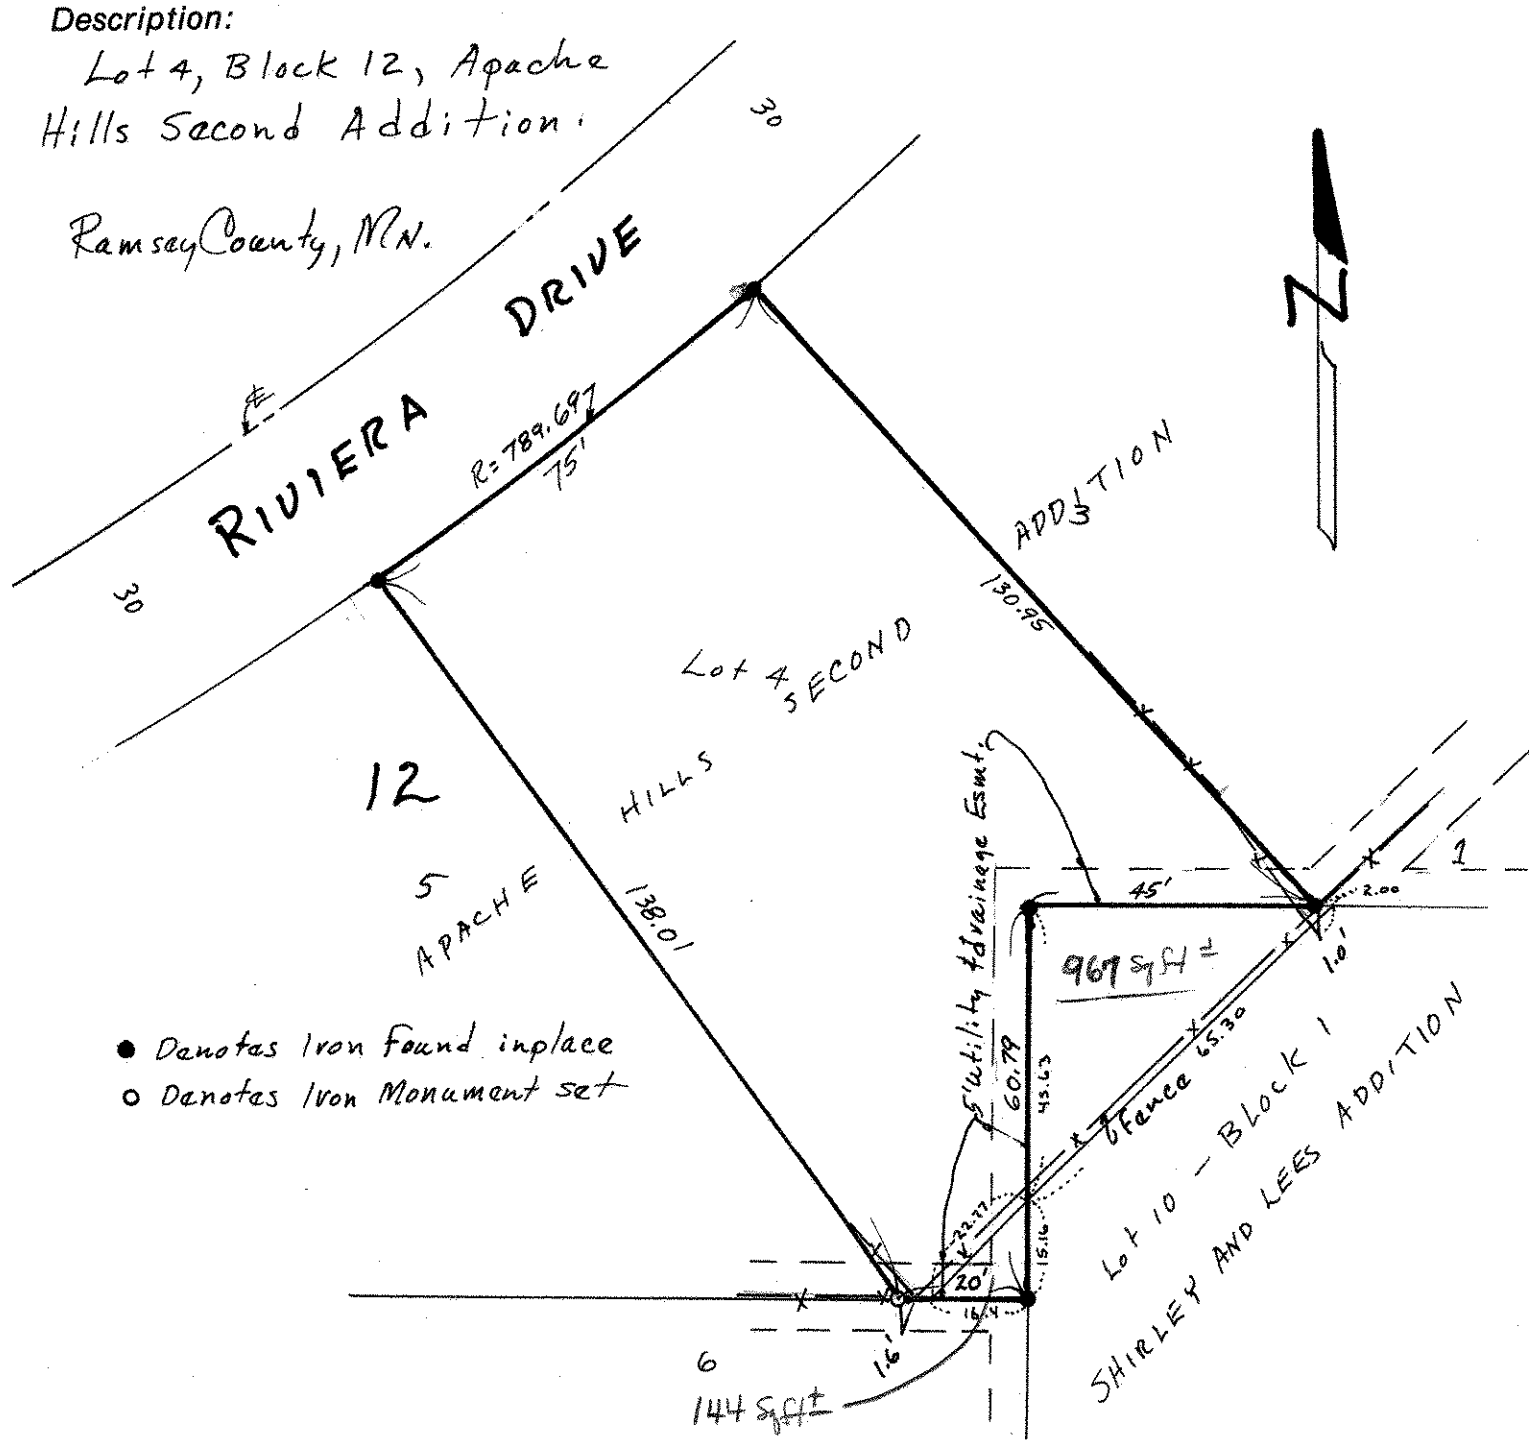
Ramsey County, MN.