

FROM THE OFFICE OF

CHARLES O. GEORGI COMPANY

2215 West County Road B

Saint Paul, Minnesota 55113

REGISTERED CIVIL ENGINEER AND LAND SURVEYOR

Certificate of Survey

I Heroby Certify that this plat shows a survey made by me of the property described on this plat, and that the corners are correctly placed as shown, and that all locations have been correctly shown.

Surveyed For Nedegaard Const.

Date May 1977

Scale 1"=50'

By Charles O. Georgi
REGISTERED LAND SURVEYOR

Description:


Lot 27,
Block 2,
North Owasso Shores
Addition No. 2,
Ramsey County, Minnesota



o Denotes Iron Pipe Monument set
February 1977 or previously.
Easements are per plat only

60 KENT ST. 60

50 LAKE BAYVIEW COURT 50

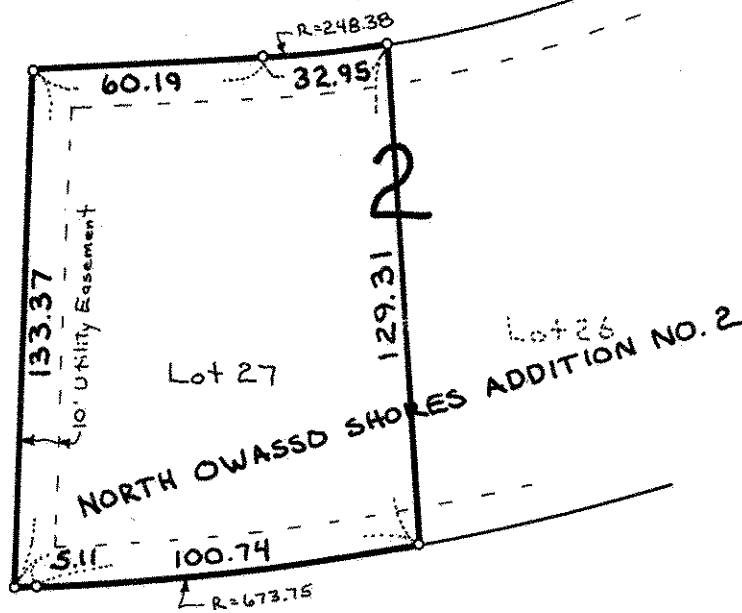

80 LAKE OWASSO BLVD. N. 80