NW 36 30 23

# Certificate of Survey

From the office of

**GEORGI- SCHMIDT & ASSOC. INC.**

3092 No. Lexington Ave., Roseville, Mn. 55113

LAND SURVEYING

483-4408

**I Hereby Certify that** this plat shows a survey made by me of the property described on this plat, and that the corners are correctly placed as shown, and that all locations have been correctly shown.

Job Number: 905

Surveyed For Oh-Ho Bldgrs

Date APRIL 1981

Scale 1" = 40'

By Donald W. Schmidt
REGISTERED LAND SURVEYOR

Description:

Lot 14. Block 1
Lakeshore Oaks Addition No. 2
Ramsey County, Minn.

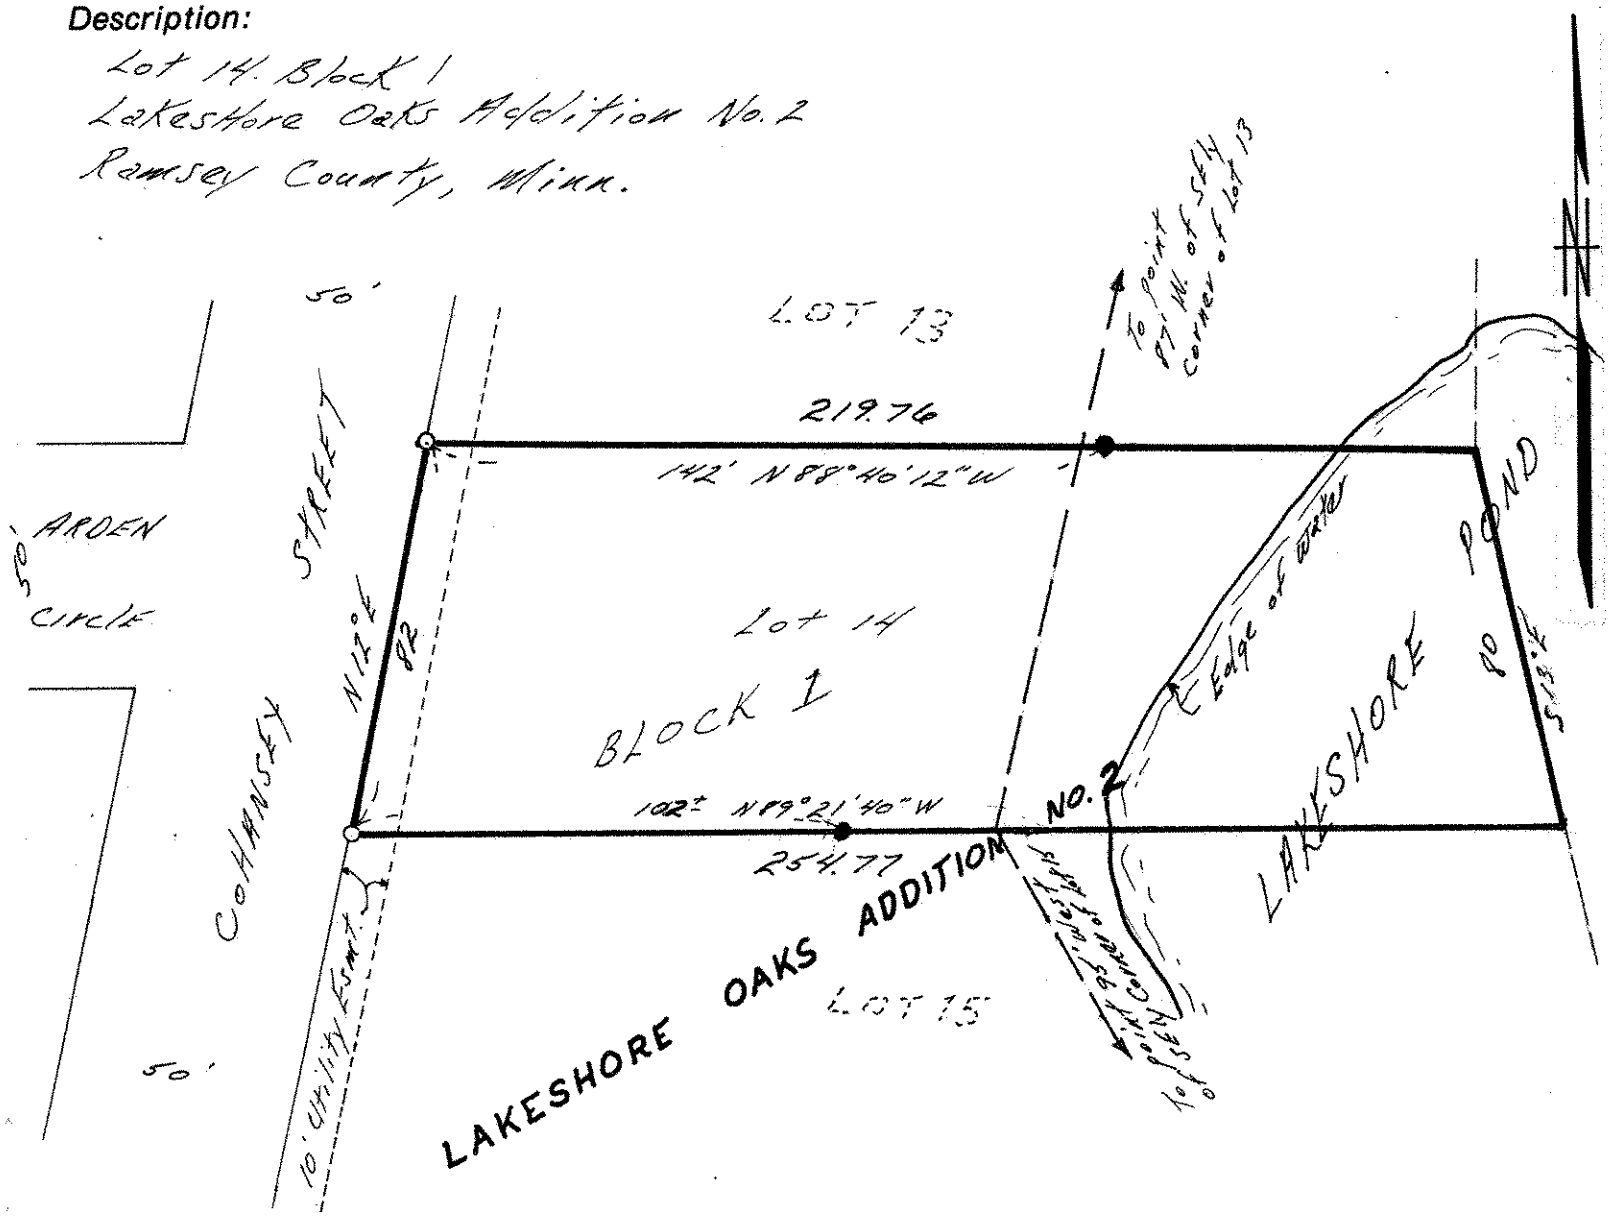


• Denotes Iron Pipe Monument Found

○ Denotes Iron Pipe Monument Set