Certificate
of Survey

CHARLES O. GEORGI COMPANY

2215 West County Road B

Saint Paul, Minnesota 55113

NW 14 30 23

REGISTERED CIVIL ENGINEER AND LAND SURVEYOR


I Hereby Certify that this plat shows a survey made by me of the property described on this plat, and that the corners are correctly placed as shown, and that all locations have been correctly shown.

Surveyed For Clyde Rendern N. 1940 Const.

Date Scale By Gale By Registered Land Surveyor

Description:

Lot 12, Black 4, Brennan's Turtle Lake Park Subject to easement of record Rumsey county Minnesota.

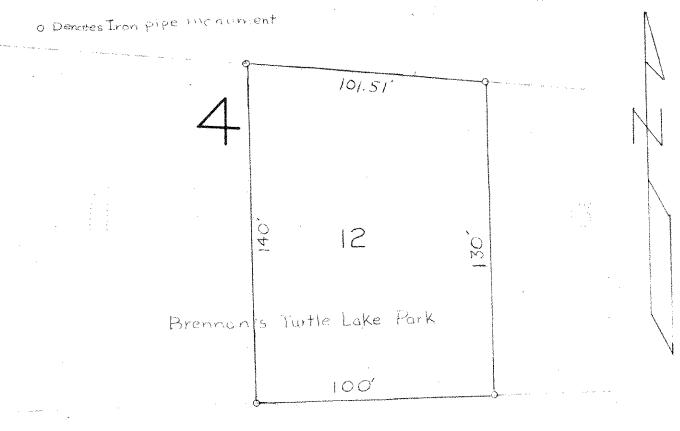

county rd. G2

43

South Line of Northwest Quarter of Sc 1101 14 T30.R23.