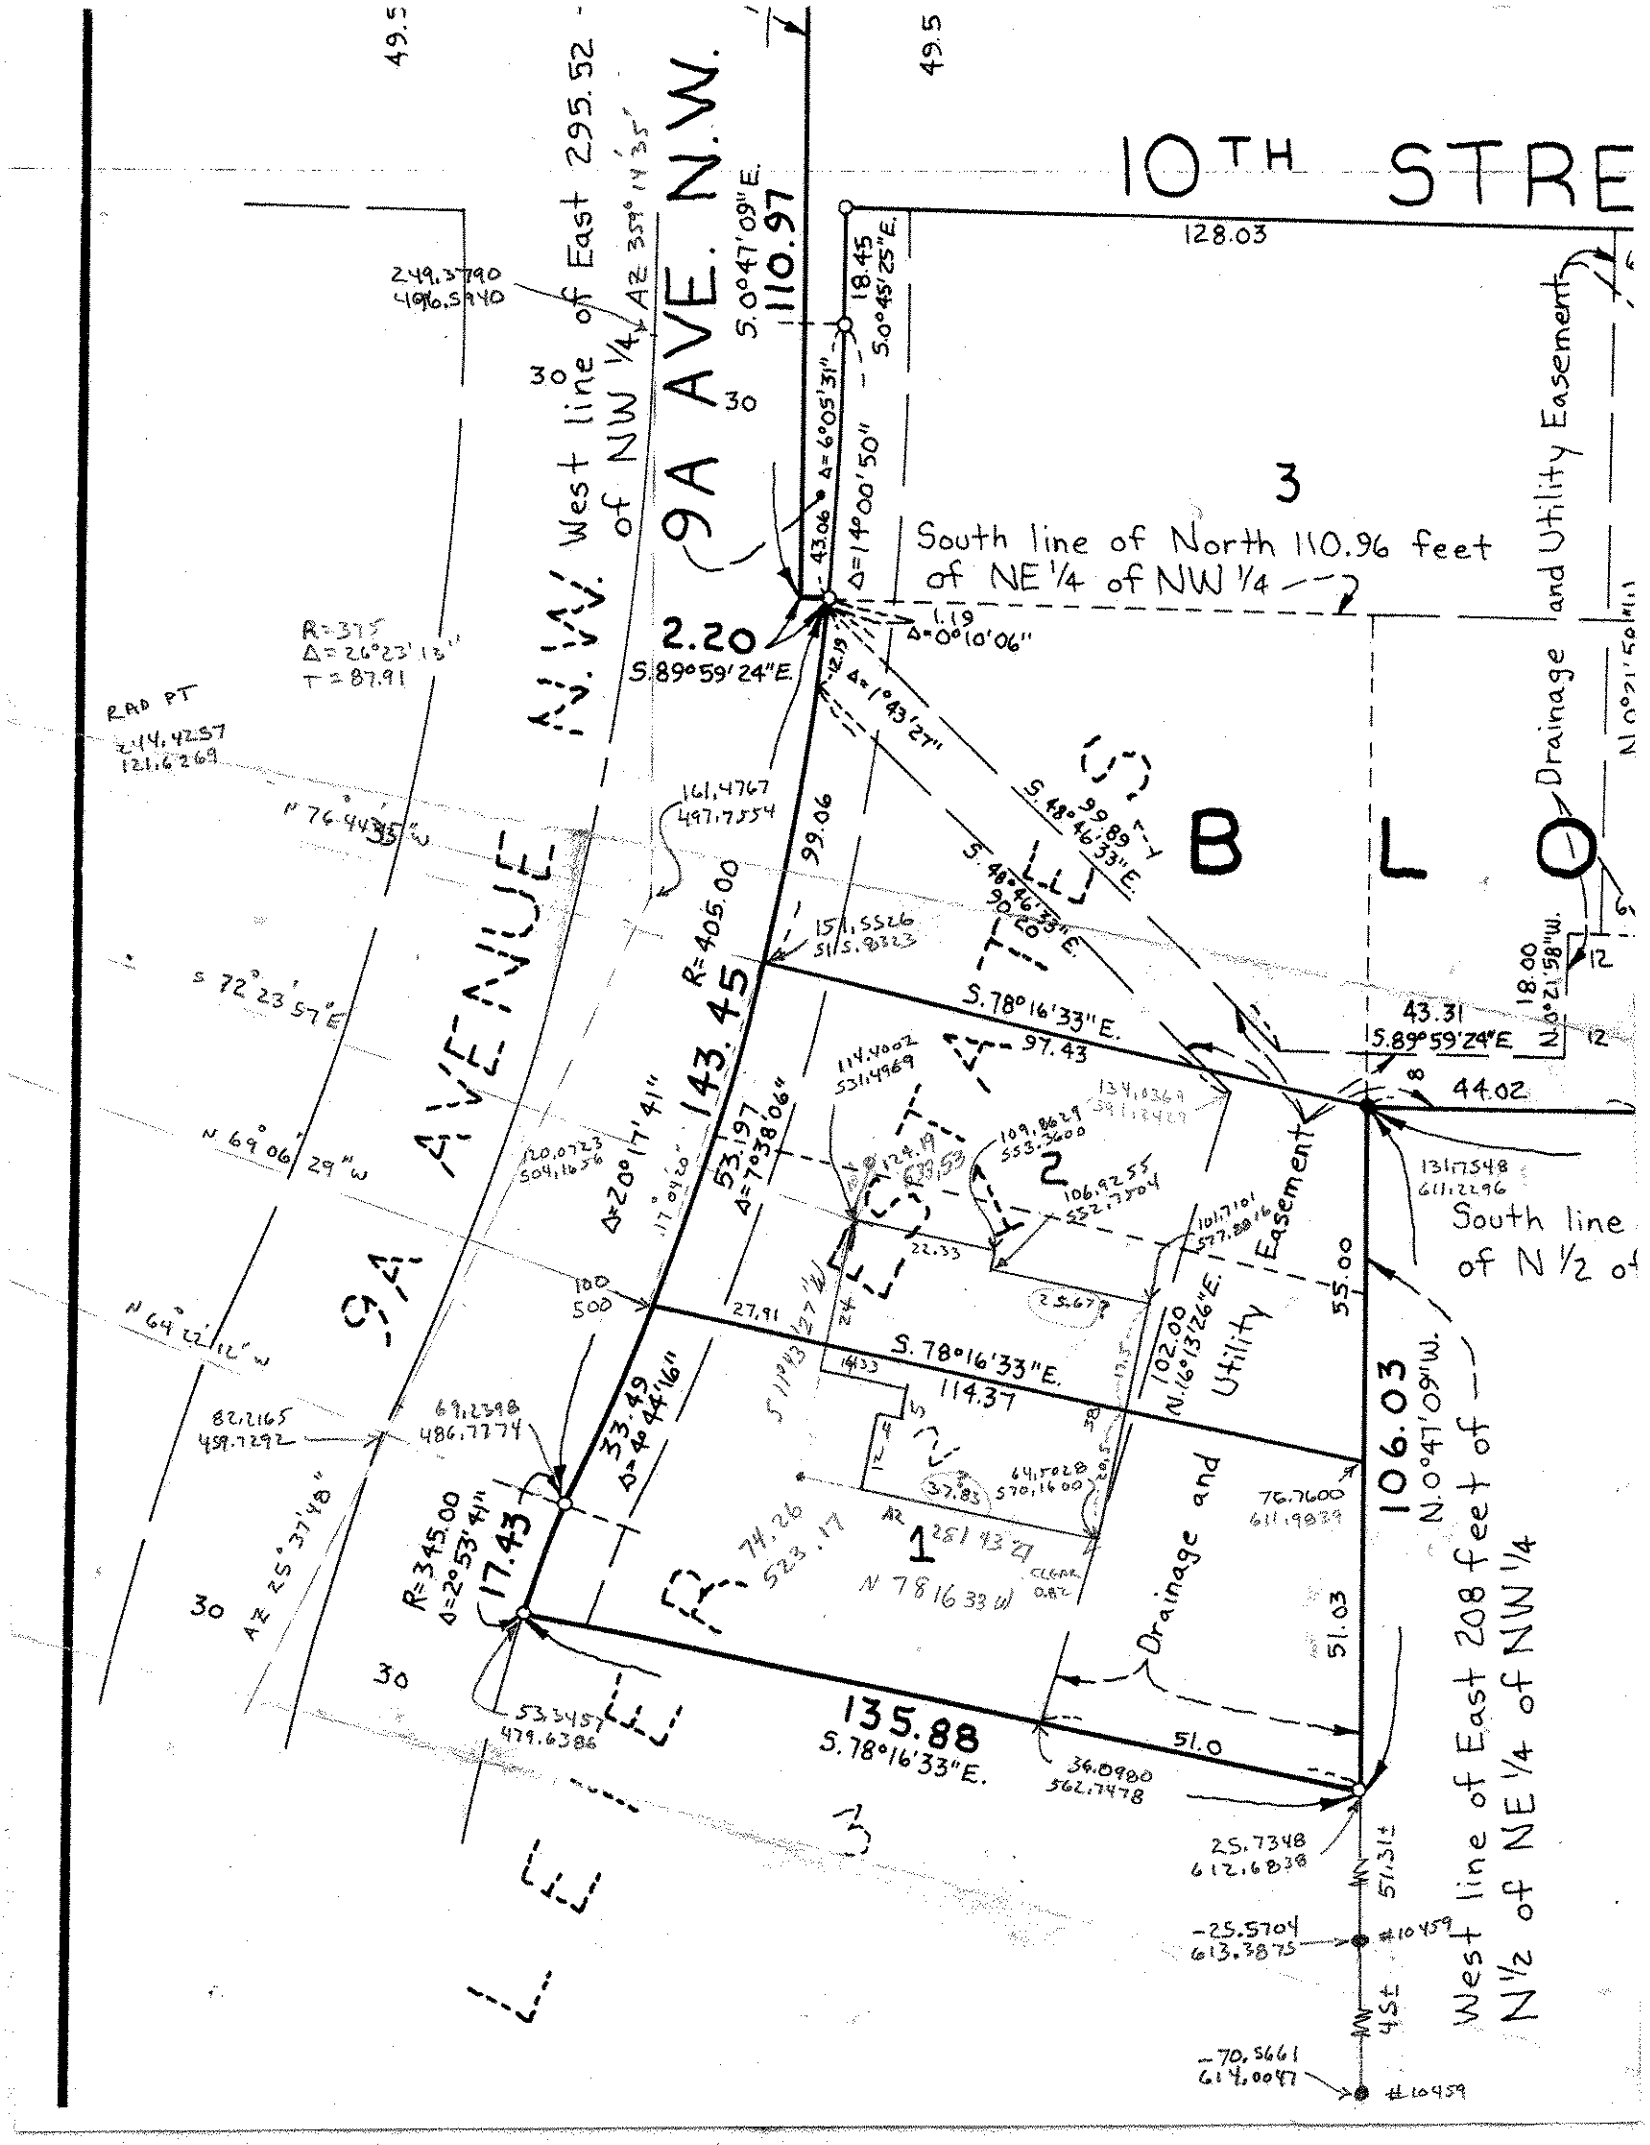
10TH STRE
128.03
49.5
49.5
West line of East 295.52 - of NW 1/4 Az 359° 14' 35"
9A AVE. N.W.
AVENUE N.W.
110.97
S.0°47'09"E.
18.45
S.0°45'25"E.
249.3790
496.5940
30
30
3
South line of North 110.96 feet of NE 1/4 of NW 1/4
Δ=6°05'31"
Δ=14°00'50"
43.06
1.19
Δ=0°10'06"
2.20
S.89°59'24"E.
R=375
Δ=26°23'13"
T=87.91
RAD PT
214.4257
121.6269
161.4767
497.7554
99.06
R=405.00
143.45
Δ=20°17'41"
Δ=7°38'06"
53.197
S.48°46'33"E.
99.89
S.48°46'33"E.
90.00
S.78°16'33"E.
97.43
B L O
Drainage and Utility Easement
N.0°21'58"W.
18.00
43.31
S.89°59'24"E.
44.02
N.0°21'58"W.
12
151.5526
515.8323
114.4002
531.4969
134.0369
591.2409
109.8629
553.3600
106.9255
552.7304
124.19
R=33.53
22.33
2
101.7101
577.5816
Utility Easement
131.7548
611.2296
South line of N 1/2 of
S 72°23'57"E.
N 69°06'29"W.
N 64°22'12"W.
120.0723
504.1656
100
500
27.91
S.11°43'27"W.
24
14.33
S.78°16'33"E.
114.37
102.00
N.16°13'26"E.
55.00
106.03
N.0°47'09"W.
West line of East 208 feet of — N 1/2 of NE 1/4 of NW 1/4
82.2165
459.7292
69.2298
486.7774
33.49
Δ=6°44'16"
R=345.00
Δ=2°53'41"
17.43
Az 25°37'48"
74.26
523.17
37.83
641.7028
570.1600
Az 281°43'27"
N 78°16'33"W.
CLOSR 0.82
70.7600
611.9839
Drainage and
51.03
30
30
53.3457
479.6386
135.88
S.78°16'33"E.
51.0
36.0980
562.7478
25.7348
612.6838
51.31±
-25.5704
613.3875
#10459
45±
-70.5661
614.0047
#10459