SE 32 30 23

FROM THE OFFICE OF

CHARLES O. GEORGI COMPANY

2215 West County Road B Saint Paul, Minnesota 55113

REGISTERED CIVIL ENGINEER AND LAND SURVEYOR

Certificate of Survey

I Hereby Certify that this plat shows a survey made by me of the property described on this plat, and that the corners are correctly placed as shown, and that all locations have been correctly shown.. Set corners on North line only To date.

Surveyed For Edward C. Perron

Date Sept 1966

Scale 1" = 100'

By Charles O. Georgi
REGISTERED LAND SURVEYOR

Description:
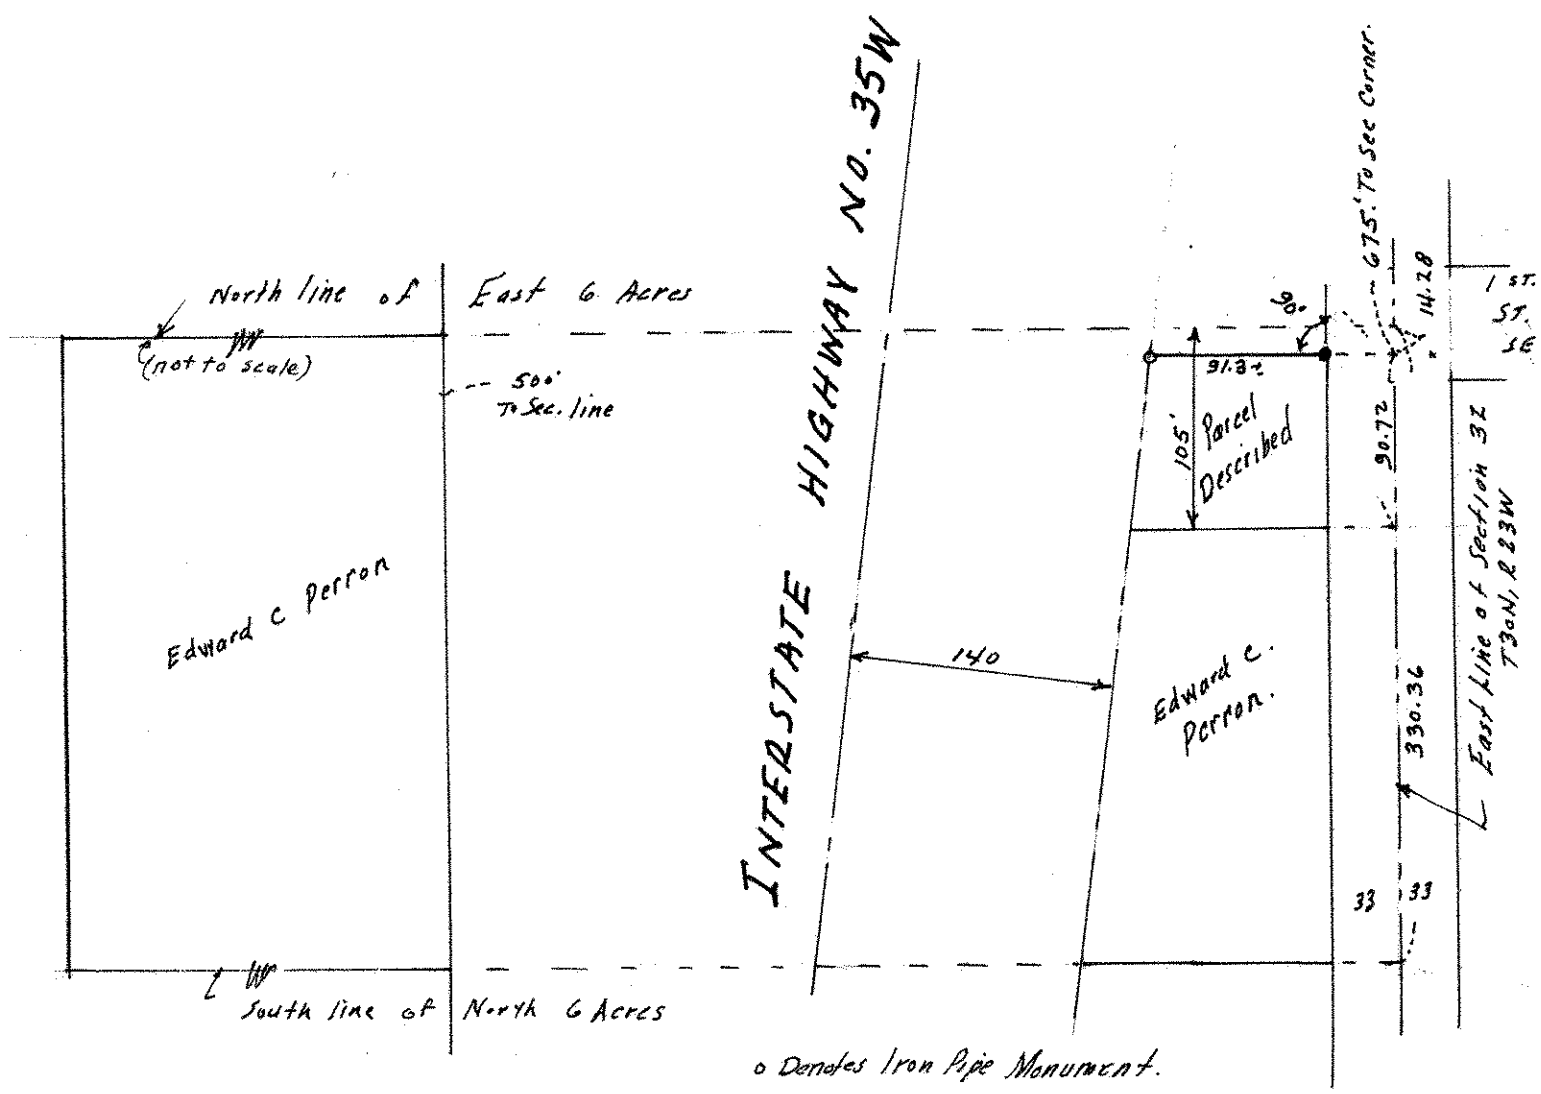
The North 105 feet of the East 6 Acres of the North 1/2 of the South 1/2 of the NE 1/4 of the NE 1/4 of Section 32, T30N, R23W Ramsey County, Minn lying Easterly of Interstate Highway No 35W except the Northerly portion thereof taken for Interstate Highway No 35W.