

FROM THE OFFICE OF

# CHARLES O. GEORGI COMPANY

2215 West County Road B

Saint Paul, Minnesota 55113

REGISTERED CIVIL ENGINEER AND LAND SURVEYOR

## Certificate of Survey

I Hereby Certify that this plat shows a survey made by me of the property described on this plat, and that the corners are correctly placed as shown, and that all locations have been correctly shown.

Surveyed For *Clarence K. Peterson*


Date *September 1968*

Scale *1" = 50'*

By *Charles O. Georgi*  
REGISTERED LAND SURVEYOR

**Description:**

*Lot 2  
Block 9  
ARDEN HILLS NO 3  
Ramsey County, Minn.*

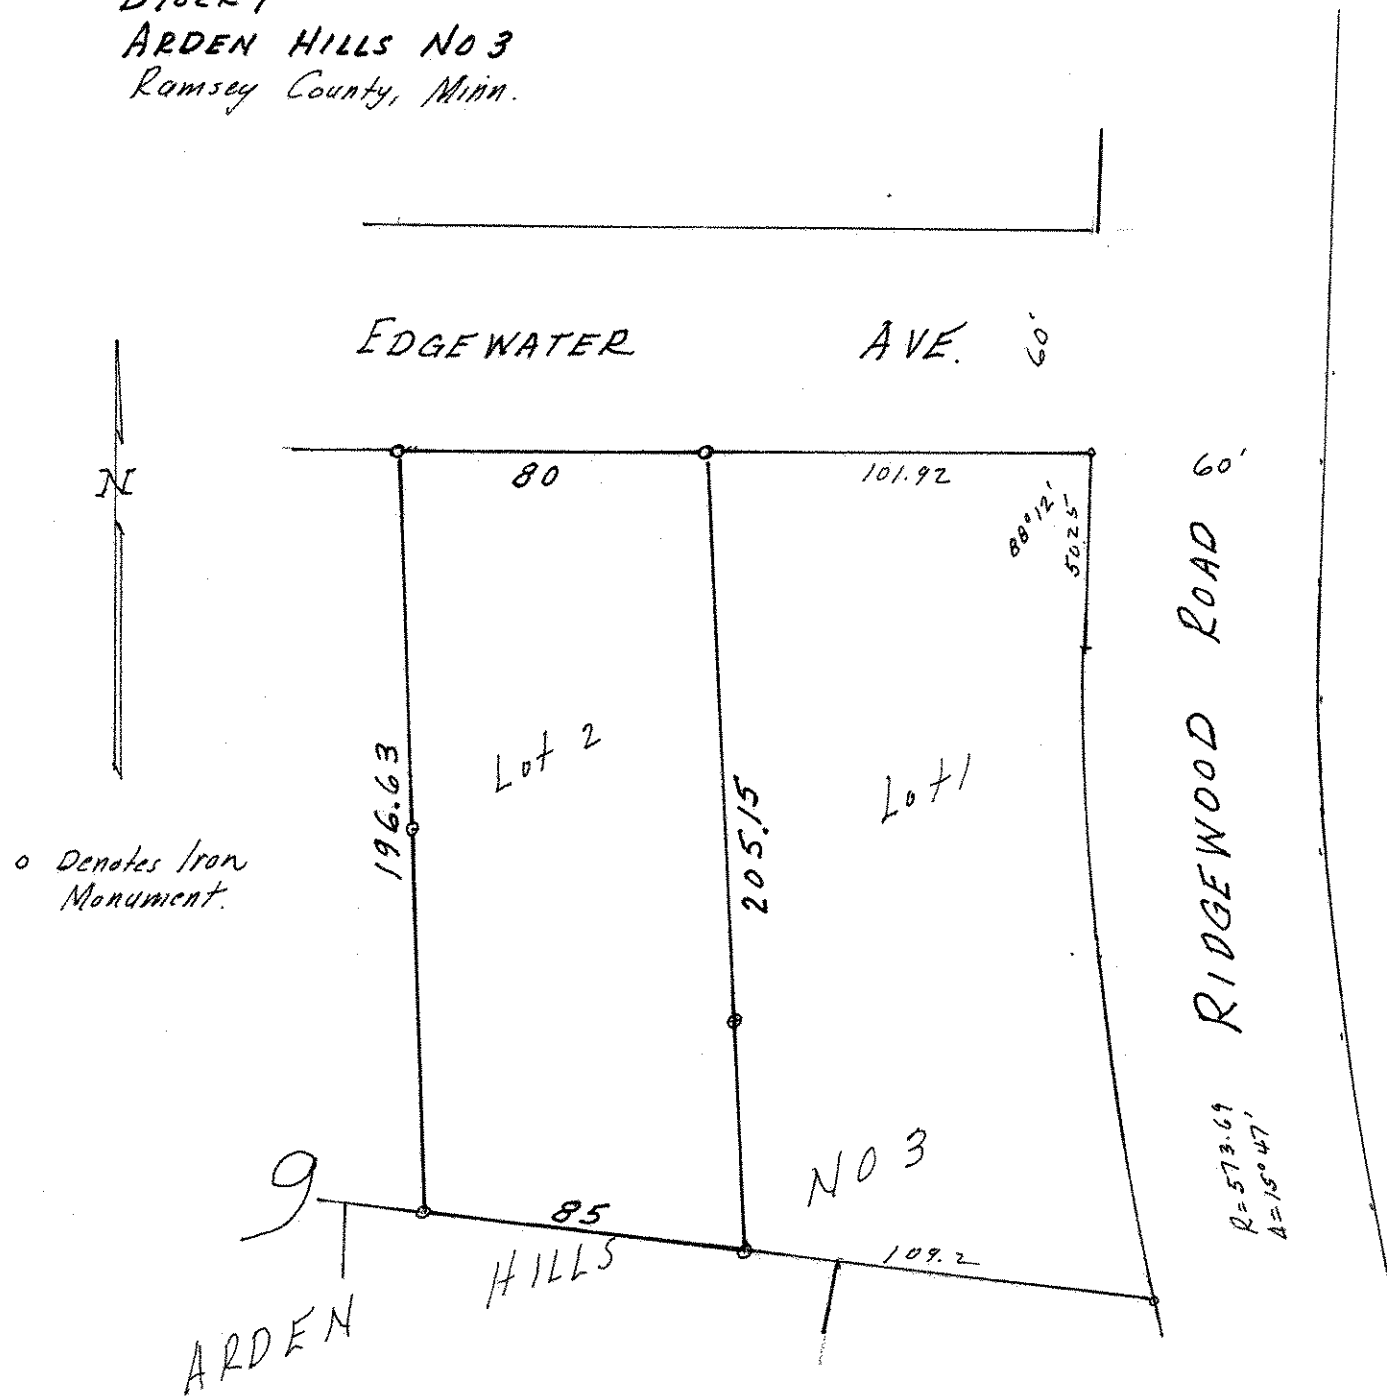

o Denotes Iron Monument.

*RIDGEWOOD ROAD 60'*  
*R = 573.69*  
*A = 15° 47'*