FROM THE OFFICE OF

Gertificate of Survey

CHARLES O. GEORGI COMPANY

2215 West County Road B

Saint Paul, Minnesota 55113

REGISTERED CIVIL ENGINEER AND LAND SURVEYOR

I Hereby Certify that this plat shows a survey made by me of the property described on this plat, and that the corners are correctly placed as shown, and that all locations have been correctly shown.

Surveyed For Eugene A. Scoles

Date June 1973

Scale /*=30'


By Shark O Levisi

Description:

Lot 3, Block 1,

Valentine Lake View No. 2,

Ramsey County, Minnesota.

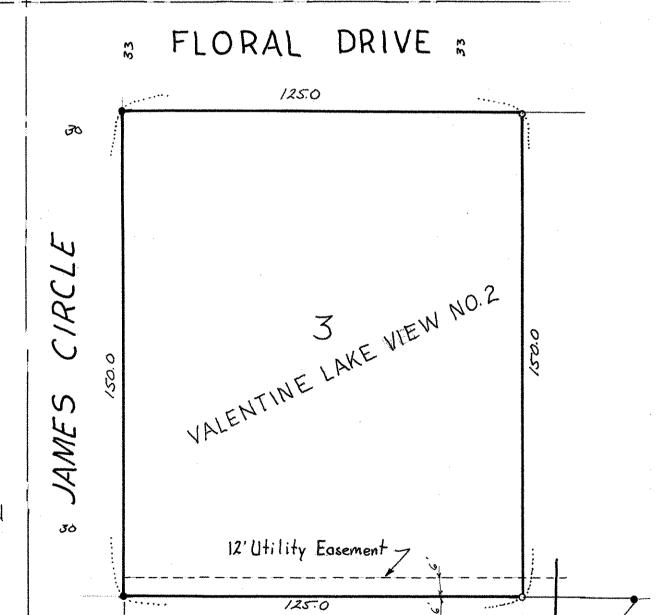

odenotes iron pipe monuments found in place. o denotes iron pipe monument