NE 21 30 23

Certificate of Survey

From the office of

GEORGI- SCHMIDT & ASSOC. INC.

3092 No. Lexington Ave., Roseville, Mn. 55113
LAND SURVEYING
483-4408

I Hereby Certify that this plat shows a survey made by me of the property described on this plat, and that the corners are correctly placed as shown,

Job Number: 4071

Surveyed For Saints Volodymyr & Olga Church

Date 9/9/83 - 8/7/90

Scale 1" = 100'

By Donald W. Schmidt
REGISTERED LAND SURVEYOR
#10459

Description: *Contains 191,328 sq. ft. or 4.392 acres, mol)
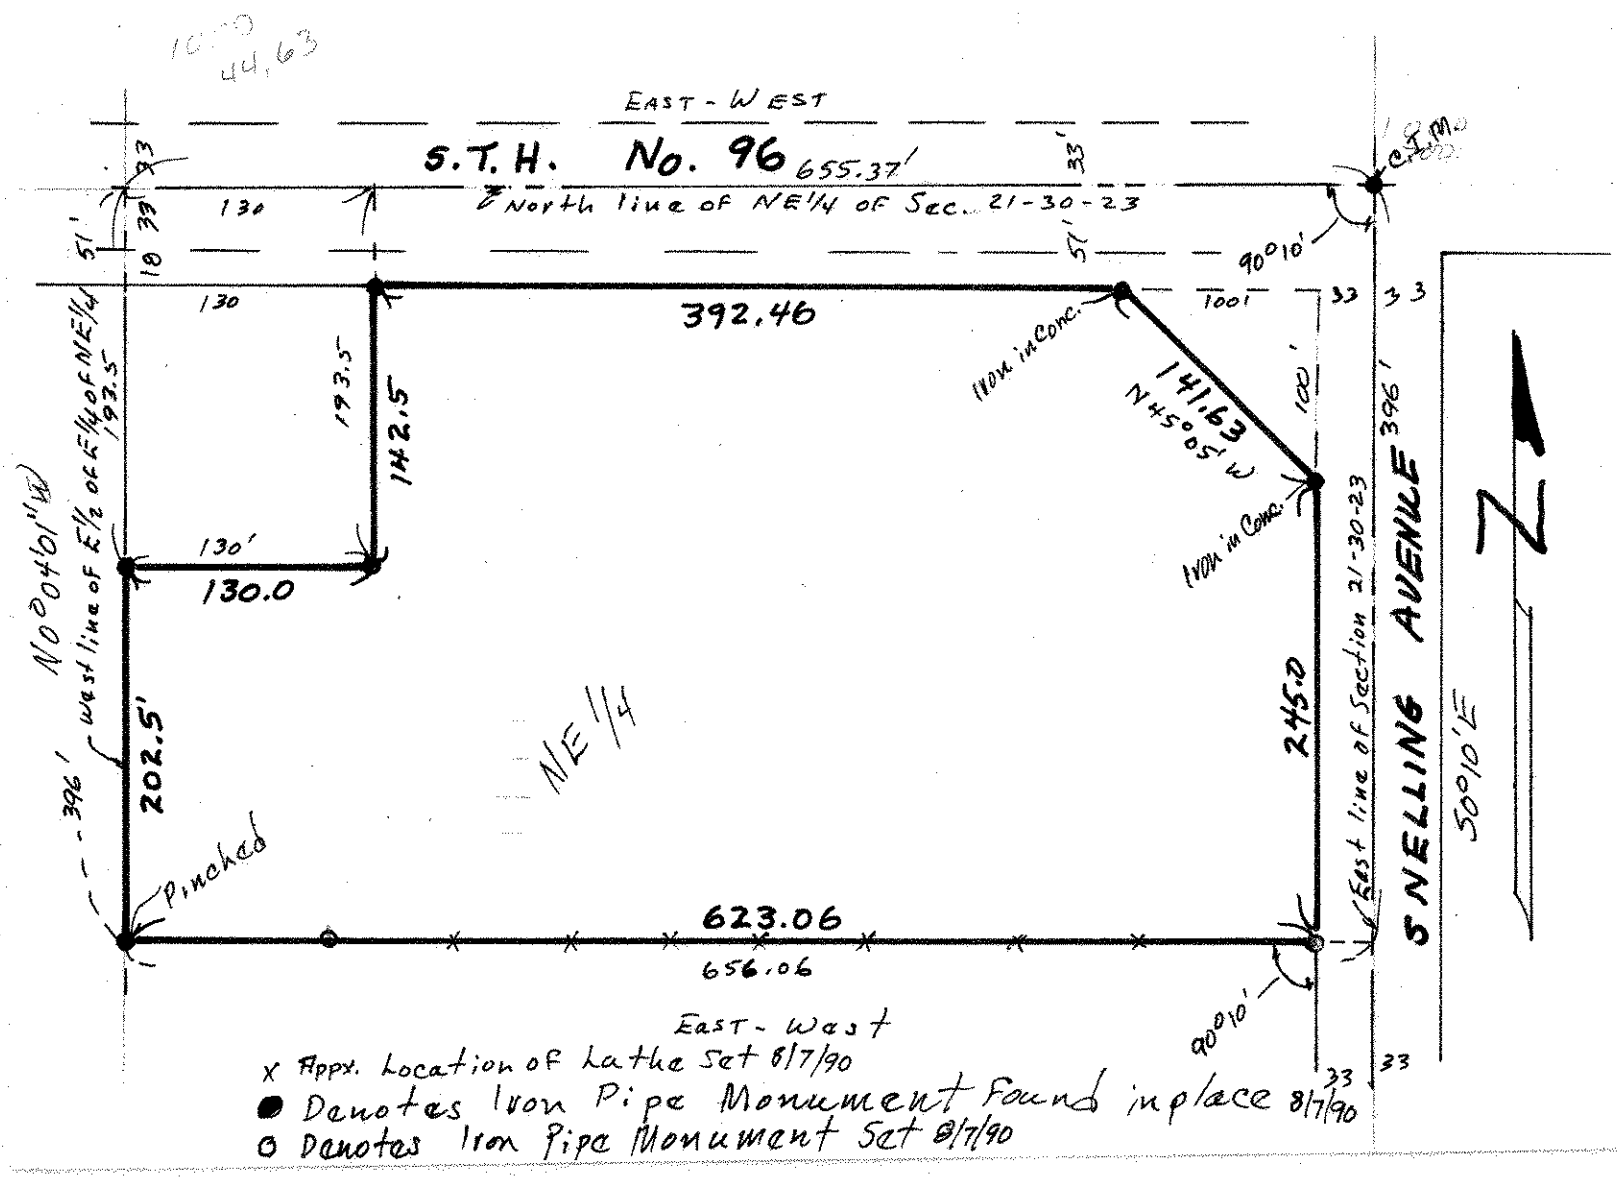
The North 396 feet of the East 1/2 of the East 1/2 of the Northeast 1/4 of Section 21, T30N, R23W, except the North 193.5 feet of the West 130 feet thereof. Subject to rights of State of Minnesota in that part thereof taken for right-of-way for Trunk Highway No. 96 and rights of the public in Snelling Avenue. According to the United States Government Survey.