

FROM THE OFFICE OF

CHARLES O. GEORGI COMPANY

2215 West County Road B

Saint Paul 13, Minnesota

REGISTERED CIVIL ENGINEER AND LAND SURVEYOR



Certificate of Survey

I Hereby Certify that this plat shows a survey made by me of the property described on this plat, and that the corners are correctly placed as shown, and that all locations have been correctly shown.

Surveyed For *Mrs. Emma Samtner*

Date..... *August 1961*.....


Scale..... *1" = 100'*.....

By *Charles O. Georgi*
REGISTERED LAND SURVEYOR

Description:

Except the South 33 feet for County Road D, the East 65 feet of the West 885 feet of the South 220 feet of the SE 1/4 of the SW 1/4 of Section 33, T30N, R23W.

*885' to West Line of SE 1/4
of SW 1/4 of Section 33, T30N, R23W*

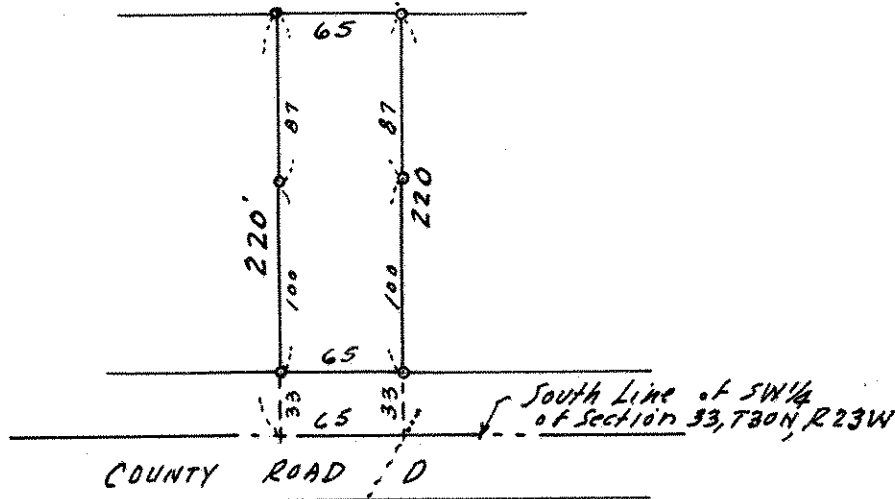

*885' to West Line of SE 1/4
of SW 1/4 of Section 33, T30N, R23W*

*South Line of SW 1/4
of Section 33, T30N, R23W*

COUNTY ROAD D

• Denotes Iron Monument.