

Certificate of Survey

From the office of
GEORGI-SCHMIDT & ASSOC. INC.
3092 No. Lexington Ave., Roseville, Mn. 55113
LAND SURVEYING
483-4408

I Hereby Certify that this plat shows a survey made by me of the property described on this plat, and that the corners are correctly placed as shown, and that all locations have been correctly shown.

Job Number: 399

Surveyed For Randy Tschida

Date June 1979


Scale 1"=40'

By Donald W. Schmidt
REGISTERED LAND SURVEYOR

Description:

Lot 11, Block 2, Lakeshore Oaks No. 2

Ramsey County, Minnesota

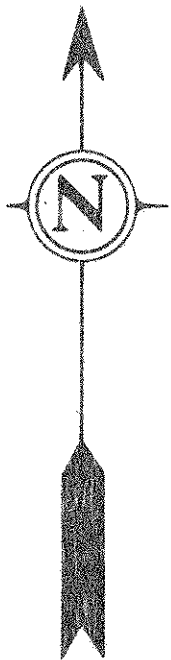

O Denotes Iron Monument

