

Appl. 29459

PR6-0640  
TELEPHONE TOWER 0640

2

# PLAT OF SURVEY


OF PROPERTY OF Robert W. Berg


Nº 643 Birch Lane South, Ramsey County, Minn.

SCALE: 1 INCH = 80 FEET

T. J. WELCH, REGISTERED SURVEYOR  
738 SURREY AVENUE, ST. PAUL 6, MINN.

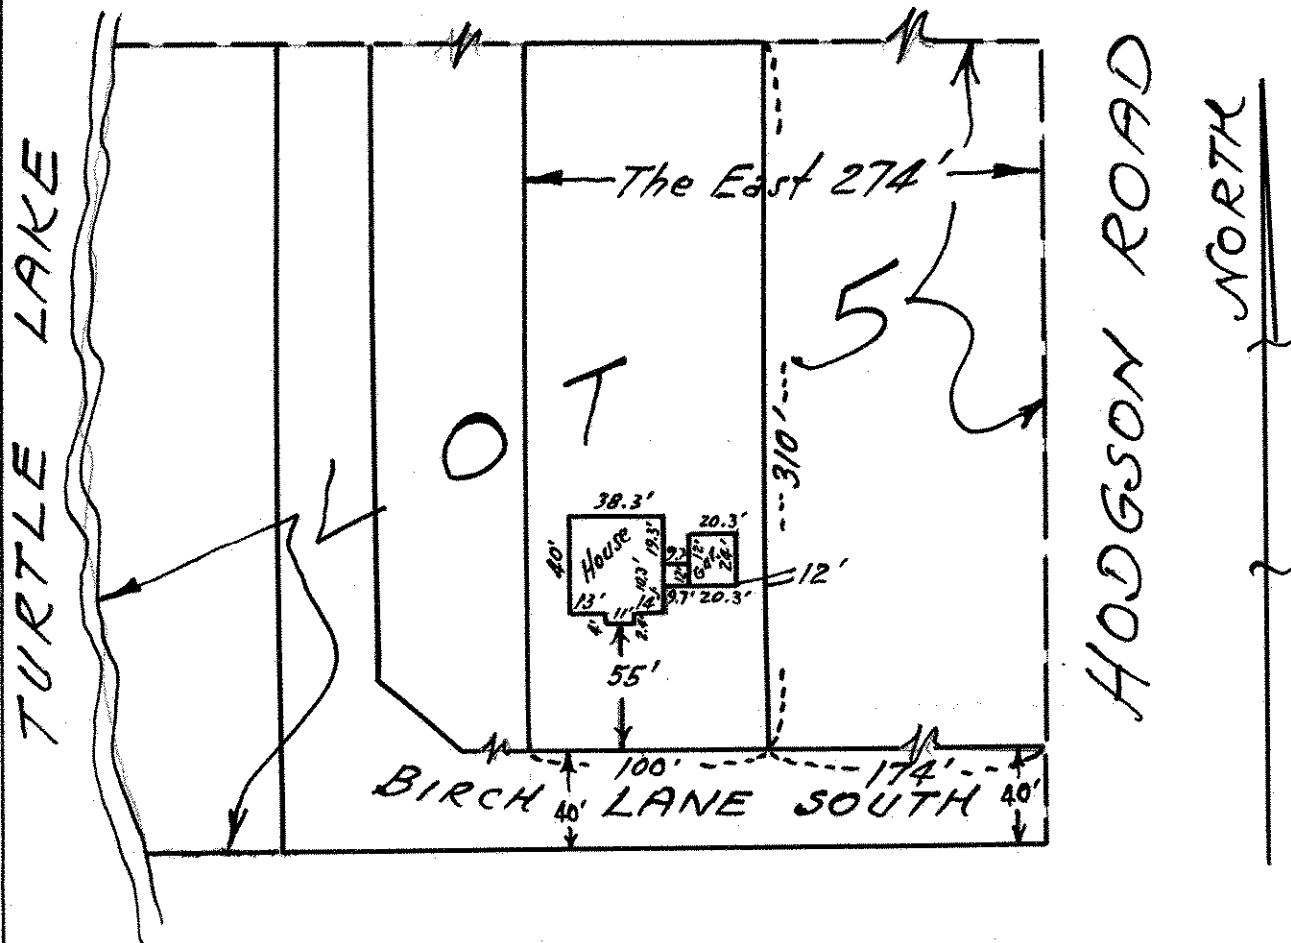

## CERTIFICATE OF SURVEY

I hereby certify that on 6-13 1959

I surveyed the property described above and that the above plat is a correct representation of said survey.

J. J. Welch

258/60