


FOAMSTOCK AND DAVIS INC.

3092 N. LEXINGTON AVE. ST. PAUL, MN. 55113 483-4408

SURVEYED FOR: Michael & Sue Luke

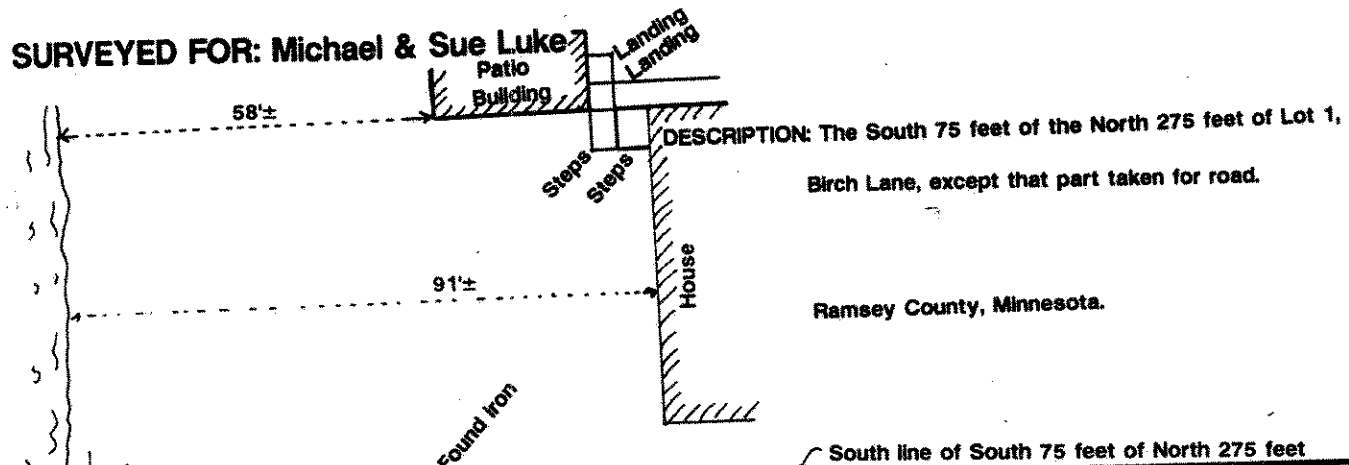

SCALE: 1"=30'

I hereby certify that this survey, plan plat, preliminary plat or report was prepared by me or under my direct supervision and that I am a duly Registered Land Surveyor under the laws of the State of Minnesota.

Dwight Schmedt

10459
Reg. No.

7/13/93
Date

931331
Job No.

Book No.