

SUBDIVISION OF LOTS 7 AND 8
SEC. 11, T. 30, R. 23.


Scale 200 Feet pr. inch

• indicates Stake

JENS PEDERSEN
Surveyor


JULY 21ST 1903.


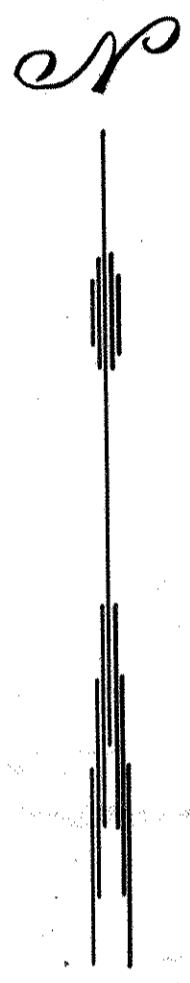



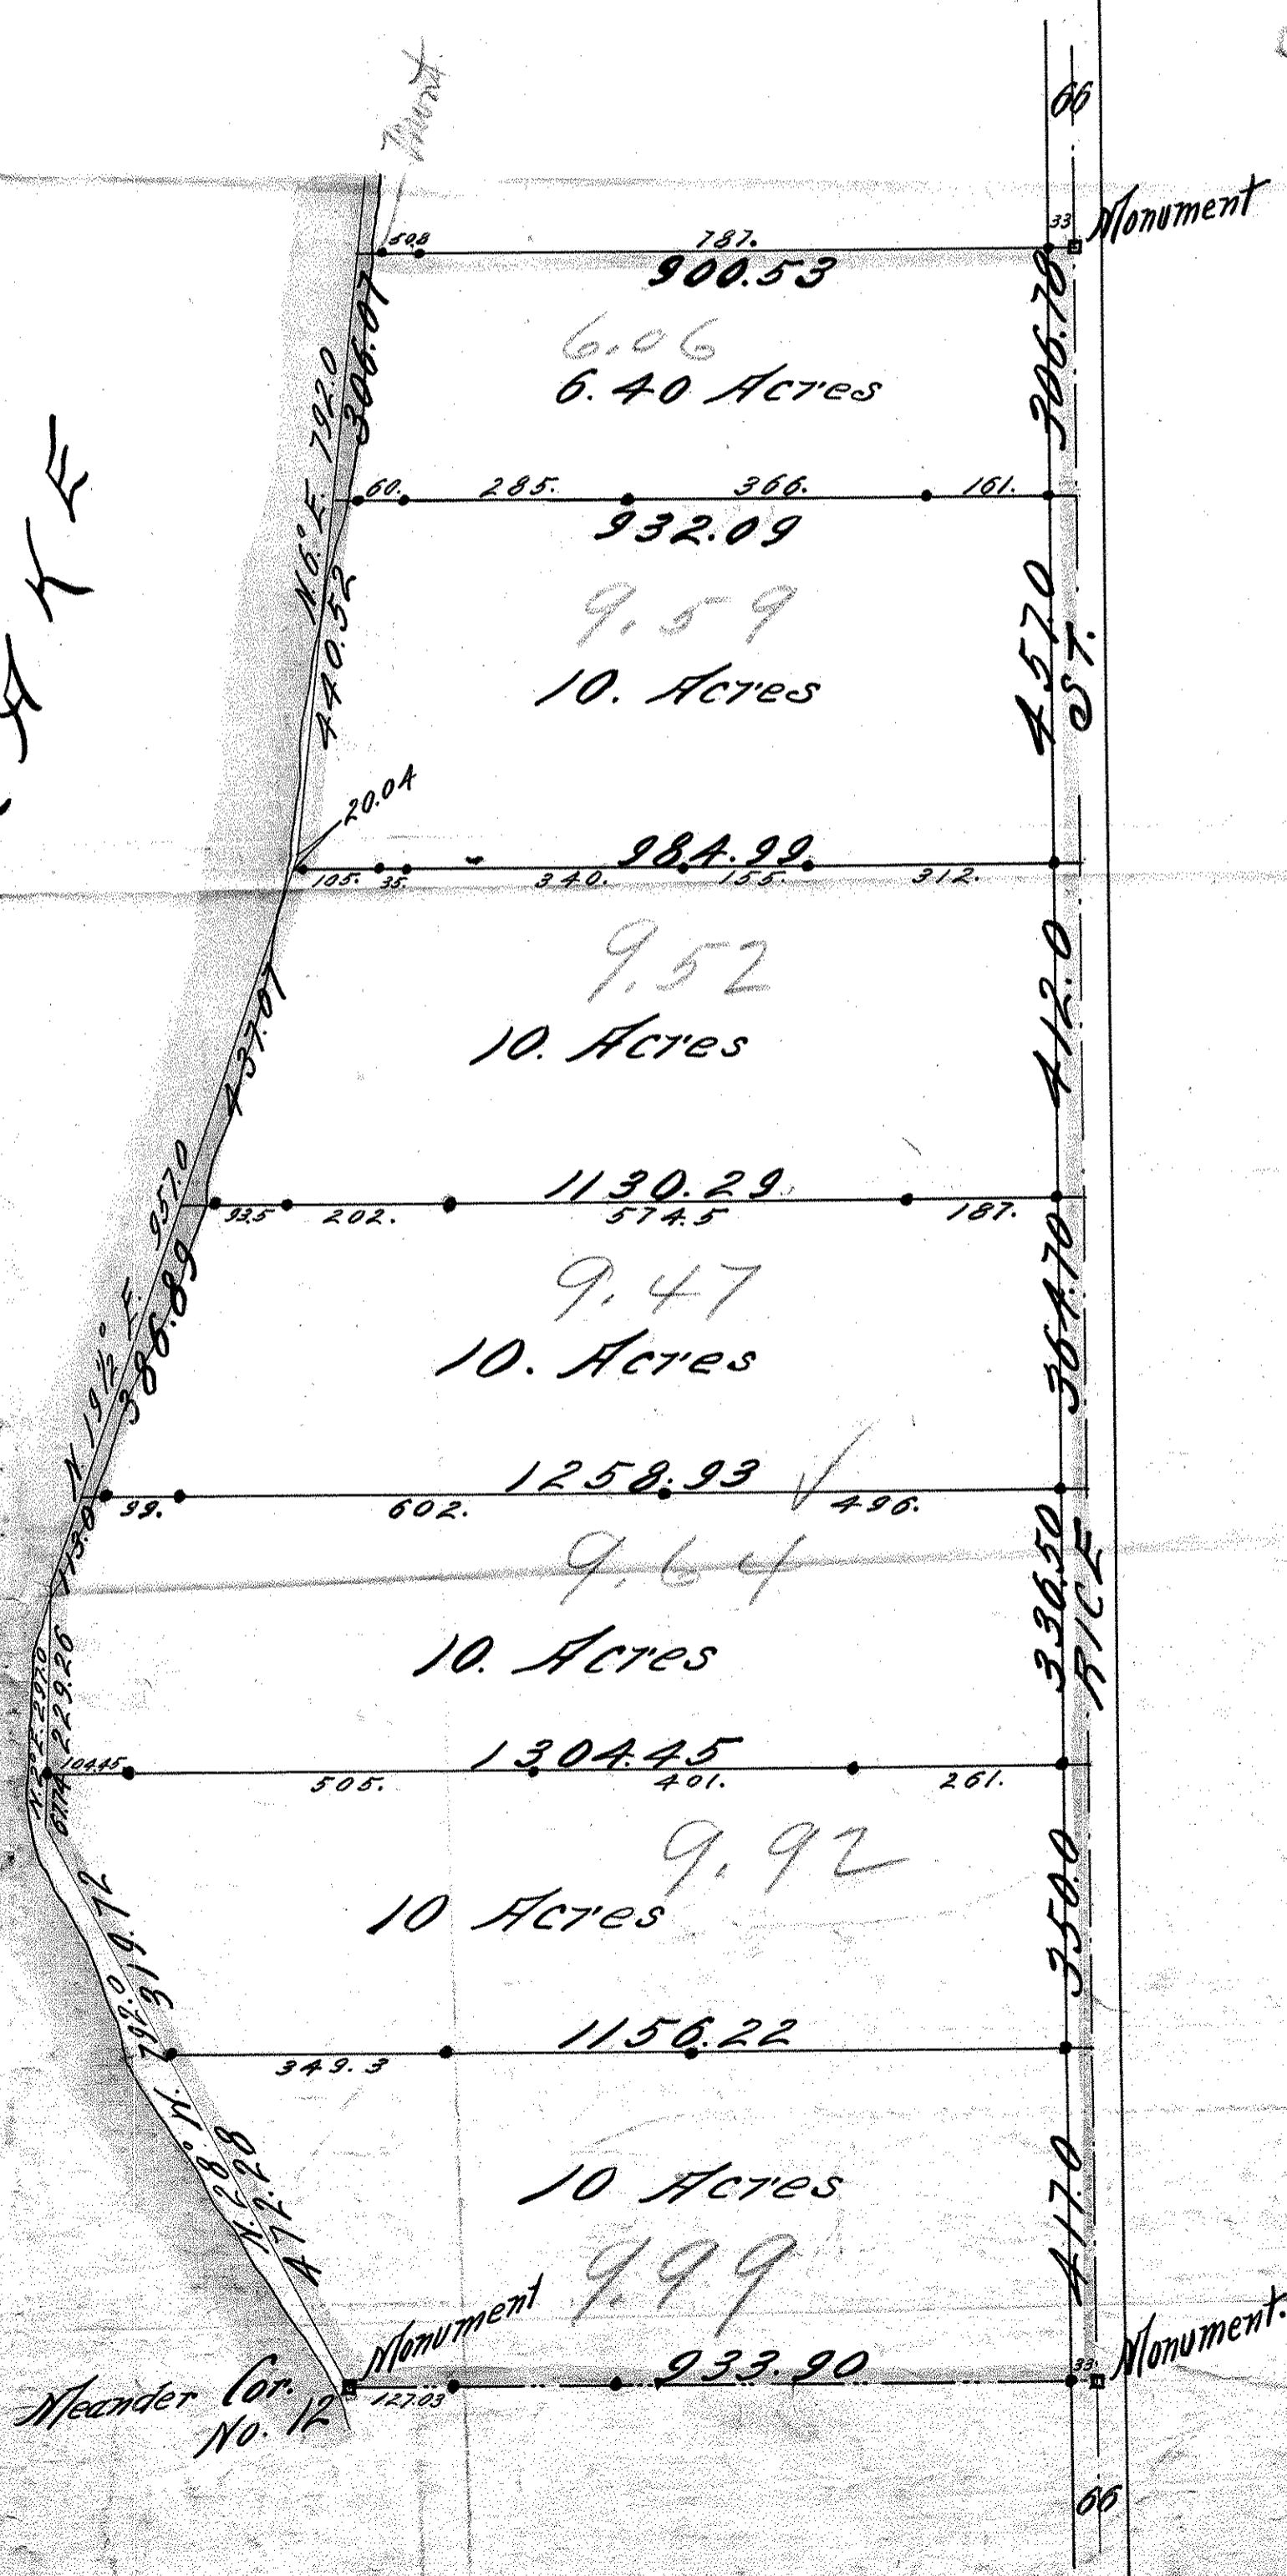

COULD NOT BE PLAT